


Section 23 Township 20 Range 11W

Well No. #3 A.Kasselman

Company Gulf

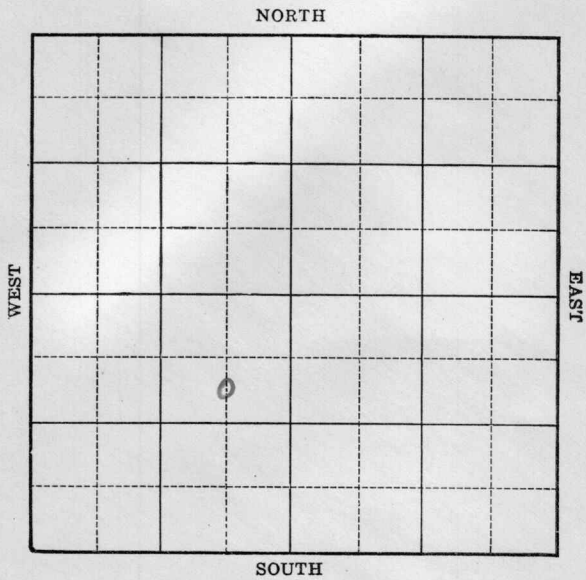

Sec. 23 Twp. 20 R. 11-WWell No. #3 A. Kasselmann FarmGulf

Company

(Silica)


990 Ft. from N. Line

Ft. from S. Line

660 Ft. from E. Line

Ft. from W. Line

Elev. 1757

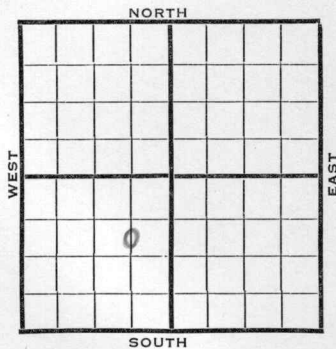

1940

REPORT

7/17

8" - 169' WOC. Drlg. 175'

7/25

Drlg. 2830'

8/2

Arb. 3267-69' T.D. 5½" - 3268½'

8/7

Arb. 3267'

5" - 3268½'

T.D. 3282'

2000 acid.

Sonimeter potential 2357 bbls.

COMPLETED

Map No. _____ Sec. 23 Twp. 20 R. 11WWell No. 3 A. Kasselman

Gulf

Company

Contractor

FIRST REPORT

C S L NE SW

990 Ft. from N. Line

_____ Ft. from S. Line

660 Ft. from E. Line

_____ Ft. from W. Line

SILICA POOL

SECTION PLAT

Location _____

Rig up _____

Drilling and Remarks:

8" - 169

WOC

Drlg. 175

RECORD

Cased _____ in., _____ ft.

Sand _____

Gas _____

Oil _____

Total Depth _____

PRODUCTION

1st 24 hrs. Nat. _____

1st 24 hrs. after shot _____

Gas _____ Cu. Ft.

Dry Hole _____

Abandoned _____

Date

JUL 17 1940

19

S. J. LEWIS Scout

Map No. 46 Sec. 23 Twp. 20 R. 11WWell No. 3 A. Kasselmann

Gulf

Company

Contractor

COMPLETED

C S L N E SW

990 Ft. from N. Line Ft. from S. Line660 Ft. from E. Line Ft. from W. Line

SECTION PLAT

SILICA POOL

Location Rig up

Drilling and Remarks:

at 8267
5" @ 3268 1/2
2000 acid

Sonimeter Rod

2357

RECORD

Cased in., ft.Sand Gas Oil Total Depth 3282

PRODUCTION

1st 24 hrs. Nat. 1st 24 hrs. after shot Gas Cu. Ft.Dry Hole Abandoned

Date

AUG 7 1949

S. J. LEWIS Scout