

McPherson **O.W.W.O.**


Form 51-5M-9-28-27423

Map No. **KANSAS** Sec. *31* Twp. *18* R. *2* *W*

Well No. *1- Roseberg* *#1 Benton* Farm

~~*Continental Oil*~~ Company
Ray Law & Harry Moore Ranch
NORTH *SWSE NW*

WEST

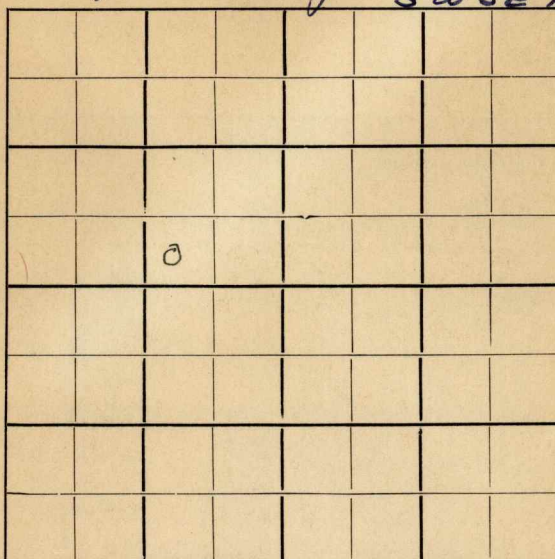

EAST

SOUTH

Location.....

Drilling Remarks

.....

.....

RECORD

Cased.....in.....ft.

Sand.....

Gas.....

Oil.....

Total Depth.....

Rig Up.....

Drilling Remarks

.....

.....

PRODUCTION

1st 24 hrs. Nat.....

1st 24 hrs. after shot.....

Gas.....cu. ft.....

Dry Hole.....

Abandoned.....

Van 1725

Twp. XPool X

Mack 1977

Co. XFacet X

Home (Ray Law) 947

S-513-B

County	McPherson	Elev.	1548
Sec.	31	Twp.	18
		Rge.	2W
Company	Ray Law & Larry Moore Ranch		
Farm Name	Bentson	No.	1

TOPS	DEPTH	LOG	DATUM	Loc. in Sec.
Anh.				SW SE NW
Tp.				OWWO
Ht. Riley	665			
Tr.				
Dg.				
B.L.				
L.	2350			
K.C.				
B.K.C.				
Ce.				
C.				
M. ch.	2954			
M.	2959			
M.				
K.				
Mz.				
Mq.				
V.				
S.				
S.				
A.				
R.				
Pf.				
G.				
T.D.				

Loc. in Sec.

SW SE NW

OWWO

Geol.

Contr.

Wiggins

Pool

McPherson

COMPLETE

JUL 30 '58

Date Comm. 4-27-58 (was Amerada #1 Roseberg)

OTD 2997 5" @ 2953 00 MAY 21 '58 CDD

300/ Keaming hole to set pipe 500'

MAY 28 '58 ~~5552~~ JUN 3 '58 \$850

BF 2%ow 24hrs JUN 11 '58 JUN 18 '58 JUN 25 '58

DD 300 5 TD JUL 2 '58 wopump

JUL 9 '58 JUL 16 '58 JUL 23 '58 POP JUL 30 '58

\$130 34BW ph 5hrs POP

~~2580 + 150~~

P2580 + 400 BW

4

~~Top~~ ~~Post~~
~~O.W.W.O.~~
~~Oil~~ ~~Field~~

County McPherson Elev. 1548
 Sec. 31 Twp. 18 Rge. 2W
 Company Ray Law & Larry Moore Ranch
 Farm Name Bentson No. 1

TOPS	DEPTH	LOG	DATUM
Anh.			
Tp.			
H. <u>Ft. Riley</u>	<u>665</u>		
Tr.			
Dg.			
B. L.			
L.	<u>2350</u>		
K. C.			
B. K. C.			
Ce.			
C.			
M. <u>ch.</u>	<u>2951</u>		
M.	<u>2959</u>		
K.			
Mz.			
Mq.			
V.			
S.			
S.			
A.			
R.			
Pf.			
G.			
T. D.			

Loc. in Sec. _____

SW SE NW

OWWO

Geol. _____

Contr. _____

Wiggins

Pool _____

McPherson

Date Comm. 4-27-58 (was Amerada #1 Roseberg)
OTD 2997 5" @ 2953 CO