


Section 24 Township 20 Range 11-W

Well No. #12 Roetzel

Company Magnolia

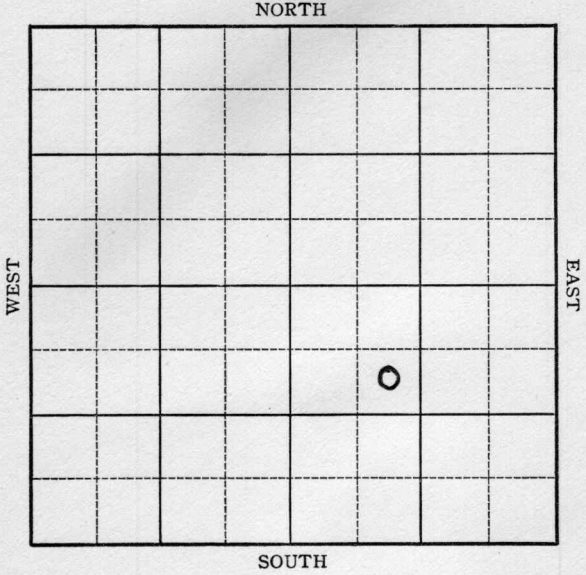

Sec. 24 Twp. 20 R. 11<sup>W</sup>


Well No. 12-Roetzel Farm  
Magnolia Company

990 Ft. from N. Line

\_\_\_\_\_ Ft. from S. Line

\_\_\_\_\_ Ft. from E. Line

990 Ft. from W. Line

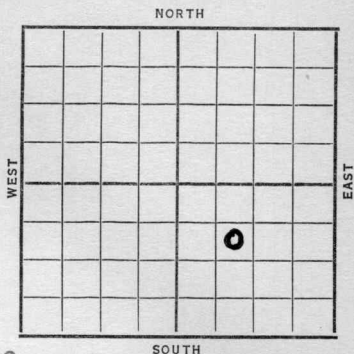

Elev. 1749

Date	REPORT
1937	
8/11	
	R.U.R.
8/20	13" @ 195'. Drlg. 1921'.
8/28	Drlg. 3280'.
9/3	Sil. 3249'. 7" @ 3250'.
	T.D. 3252'. RUST.
	No shows reported.
9/8	7" @ 3241'.
	Sil. 3242'.
	T.D. 3253'.
	Potl. 1828 bbls.
	COMPLETED

*Barton* **KANSAS**

Map No. \_\_\_\_\_ Sec. 24 Twp. 20 R. 11<sup>w</sup>

Well No. 12 - Roetzgel

Magnolia Company

Contractor \_\_\_\_\_

**FIRST REPORT**

**SECTION PLAT**

990 Ft. from N. Line

\_\_\_\_\_ Ft. from S. Line

\_\_\_\_\_ Ft. from E. Line

990 Ft. from W. Line

		0	

Location \_\_\_\_\_

Rig up \_\_\_\_\_

Drilling and Remarks:

*R. U. R.*

**RECORD**

Cased \_\_\_\_\_ in., \_\_\_\_\_ ft.

Sand \_\_\_\_\_

Gas \_\_\_\_\_

Oil \_\_\_\_\_

Total Depth \_\_\_\_\_

**PRODUCTION**

1st 24 hrs. Nat. \_\_\_\_\_

1st 24 hrs. after shot \_\_\_\_\_

Gas \_\_\_\_\_ Cu. Ft.

Dry Hole \_\_\_\_\_

Abandoned \_\_\_\_\_

Date

AUG 11 1937 19

H. D. Hatfield Scout

Map No. \_\_\_\_\_ Sec. 24 Twp. 20 R. 11W

Well No. 12-Boetzell

Magnolia

Company \_\_\_\_\_

Contractor \_\_\_\_\_

**COMPLETED**

**SECTION PLAT**

		0	

990 Ft. from N. Line

\_\_\_\_\_ Ft. from S. Line

\_\_\_\_\_ Ft. from E. Line

990 Ft. from W. Line

Location \_\_\_\_\_

Rig up \_\_\_\_\_

Drilling and Remarks:

Rot.  
1828 lbs

**RECORD**

Cased 7 in., 3240 ft.

Sand lubricous 3242

Gas \_\_\_\_\_

Oil \_\_\_\_\_

Total Depth 3253

**PRODUCTION**

1st 24 hrs. Nat: \_\_\_\_\_

1st 24 hrs. after shot \_\_\_\_\_

Gas \_\_\_\_\_ Cu. Ft.

Dry Hole \_\_\_\_\_

Abandoned \_\_\_\_\_

Date

SEP 8 1937

19

H. D. Hatfield

Scout