


Barton

Section 24 Township 20 Range 11-W

Well No. 15 Roetzel

Company Magnolia

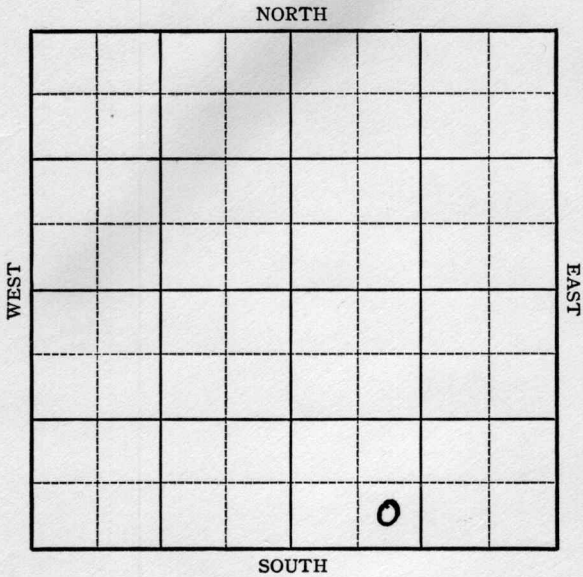

Sec. 24 Twp. 20 R. 11-W

Well No. #15 Roetzel Farm

Magnolia Company


_____ Ft. from N. Line

330 Ft. from S. Line

_____ Ft. from E. Line

990 Ft. from W. Line

Elev. 1747

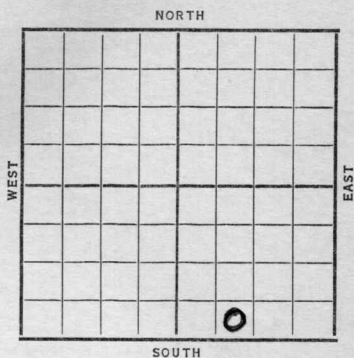

Date	REPORT
1937	
10/6	S. H.
10/15	13" @ 195'. Drlg. 2040'.
10/22	Coring 3247'.
10/29	Sil. 3252'. T.D. 3256'.
	7" @ 3253'. C.O. No shows
	reported.
11/3	7" @ 3253'.
	Sil. 3252'.
	T.D. 3269'.
	1000 acid.
	Pot. 1301 bbls.
	COMPLETED

Map No. _____ Sec. 24 Twp. 20 R. 11W

Well No. 15 Roetzel

Magnolia

Company _____

Contractor _____

FIRST REPORT

SECTION PLAT

SE SW SE

_____ Ft. from N. Line

330 Ft. from S. Line

_____ Ft. from E. Line

990 Ft. from W. Line

			0

Location _____

Rig up _____

Drilling and Remarks:

S H

RECORD

Cased _____ in., _____ ft.

Sand _____

Gas _____

Oil _____

Total Depth _____

PRODUCTION

1st 24 hrs. Nat. _____

1st 24 hrs. after shot _____

Gas _____ Cu. Ft.

Dry Hole _____

Abandoned _____

Date

OCT - 6 1887

19

H. D. Hatfield Scout

Barton

Map No. _____ Sec. 24 Twp. 20 R. 11W

Well No. 15 Roetzel

Magnolia Company

Contractor _____

COMPLETED

SE SW SE

_____ Ft. from N. Line

330 Ft. from S. Line

_____ Ft. from E. Line

990 Ft. from W. Line

SECTION PLAT

			0

Location _____

Rig up _____

Drilling and Remarks:

1000 Acid

POT-1301

RECORD

Cased 7 in., 3253 ft.

Sand sil 3252

Gas _____

Oil _____

Total Depth 3269

PRODUCTION

1st 24 hrs. Nat. _____

1st 24 hrs. after shot _____

Gas ↗ _____ Cu. Ft.

Dry Hole _____

Abandoned _____

Date

NOV 3 1937

19

H. D. Hatfield Scout