

KANSAS

Form 51—5M—7-40—Palace


Barton

Section 24 Township 20 Range 11-W

Well No. #19 Roetzel

Company Magnolia

NORTH Silica Pool

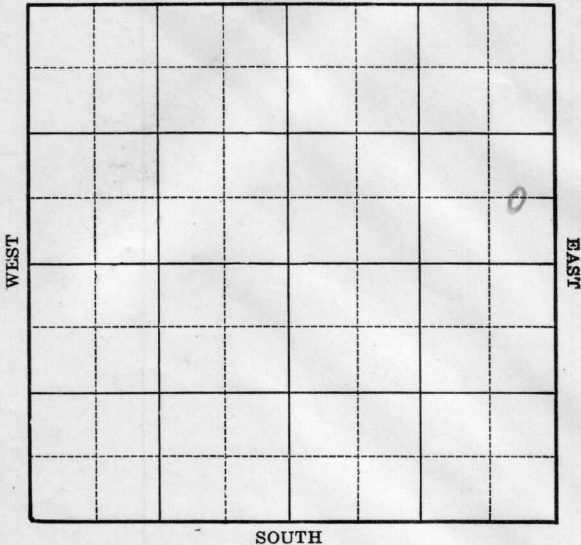


Sec. 24 Twp. 20 R. 11-WWell No. #19 Roetzel FarmMagnolia Company

(Silica)

 Ft. from N. Line660 Ft. from S. Line330 Ft. from E. Line Ft. from W. Line

Elev. 1747

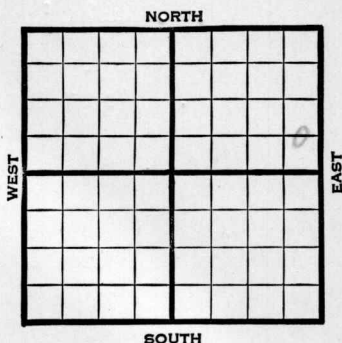

1940	REPORT
10/23	Location
10/31	10" - 213' Drlg. 1610'
11/7	Drlg. 2950'
11/14	Arb. 3254-55' T.D. 5" - 3255'
	RUST.
11/21	Swab 92 bbls. in 8 hours.
11/27	T.D. 3258' Pump 126 oil & 41
	water 24 hrs. Shut down.
12/5	Pump 52 oil & 24 water 12 hrs.
	Shut down.
12/12	" "
12/19	P. B.
12/26	"
1941	
1/2	100' oil, 1400' water 2 hours.
1/9	3259' T.D. Swab 21 bbls. oil &
	3XX 8 water off bottom.
	OVER

1941

1/15

Arb. 3254'

5" - 3255'

T.D. 3276'

Pump 121 oil & 5 water, potential
40.4 Gravity

COMPLETED

Map No. 46 Sec. 24 Twp. 20 R. 11WWell No. 19 RoetzelMagnolia

Company

Contractor


FIRST REPORT

C E L S E N E

 Ft. from N. Line660 Ft. from S. Line330 Ft. from E. Line Ft. from W. Line

SILICA POOL

SECTION PLAT

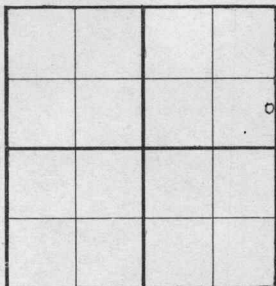Location XRig up

Drilling and Remarks:

RECORD

Cased in., ft.Sand Gas Oil Total Depth

PRODUCTION

1st 24 hrs. Nat. 1st 24 hrs. after shot Gas Cu. Ft.Dry Hole Abandoned

Date

OCT 23 1940 19S. J. LEWIS Scout

Map No. 46 Sec. 24 Twp. 20 R. 11WWell No. 19 RoetzelMagnolia

Company

Contractor

COMPLETED

C E L S E N E

SECTION PLAT

			o

 Ft. from N. Line660 Ft. from S. Line330 Ft. from E. Line Ft. from W. Line

SILICA POOL

Location Rig up

Drilling and Remarks:

*CR & 3254**5" @ 3255.**Pump 121 oil**5W P & X.**40th Gr.*

RECORD

Cased in., ft.Sand Gas Oil Total Depth 3276

PRODUCTION

1st 24 hrs. Nat. 1st 24 hrs. after shot Gas Cu. Ft.Dry Hole Abandoned

Date

JAN 15 1941 19

S. J. LEWIS

Scout