

McPherson

KANSAS



Sec. 31 Twp. 18 R. 2W


Well No. #1 Park Clark Farm

A. D. Allison
Meade Prod. et al

Company

McPherson Pool (Aussman & Sons, ~~Cont.~~)

_____ Ft. from N. Line
990'
_____ Ft. from S. Line
330'
_____ Ft. from E. Line
_____ Ft. from W. Line
NE SE SE

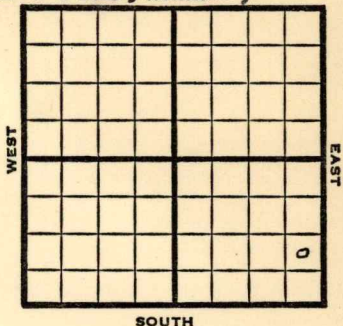

1949 Elev. 1557' REPORT

7/6 10" @ 118'
Drlg. 1964'

7/12 KC 2339'-45'
TD 2345'
7" @ 2340'

7/20 Abandoned
K.C. 2339'
7" @ 2340'
TD 2345'

ABANDONED

O. W. D. D

1950

1/11 Old TD 2345'
Drlg. to Miss
3/22 5" Liner 2907'
Wtr 2971-73'
Oil 2978-85'
TD 2998'
1500' fluid
700' wtr
800' oil
Swab 50 Oil 4 hrs.
Comp 50 BOPD
25 wtr.
Comp

COMPLETED

Kansas

Map No. _____ Sec. 31 Twp. 18 R. 2W

Well No. 1 Park

Meade Prod. etal. Company

Aussman & Sons Contractor

NE SE SE

FIRST REPORT
SECTION PLAT

_____ Ft. from N. Line

990 Ft. from S. Line

330 Ft. from E. Line

_____ Ft. from W. Line

			6

McPherson County

Location _____

Rig up _____

Drilling and Remarks:

10" @ 118
drlg. 1964

RECORD

Cased _____ in., _____ ft.

Sand _____

Gas _____

Oil _____

Total Depth _____

PRODUCTION

1st 24 hrs. Nat. _____

1st 24 hrs. after shot _____

Gas _____ Cu. Ft.

Dry Hole _____

Abandoned _____

Date

JUL 6 1949 19

S. J. LEWIS Scout

Kansas

OWDD

McPherson Pool

Map No. _____ Sec. 31 Twp. 18 R. 2W

Well No. 1 Clark

A. D. Allison Company

Contractor

NE SE SE O.W.D.D

SECTION PLAT

_____ Ft. from N. Line

990 Ft. from S. Line

330 Ft. from E. Line

_____ Ft. from W. Line

FIRST		REPORT	
			0

McPherson County

Location _____

Rig up _____

Drilling and Remarks:

Old TD 2345
drlg. to Miss.

RECORD

Cased _____ in., _____ ft.

Sand _____

Gas _____

Oil _____

Total Depth _____

PRODUCTION

1st 24 hrs. Nat. _____

1st 24 hrs. after shot _____

Gas _____ Cu. Ft.

Dry Hole _____

Abandoned _____

Date

JAN 11 1950 19

J. E. TYRA Scout

Map No. _____ Sec. 31 Twp. 18 R. 2W

Well No. 1 Clark

A. D. Allison Company

Contractor

NE SE SE

E-1. 1557

SECTION PLAT

_____ Ft. from N. Line

990 Ft. from S. Line

330 Ft. from E. Line

_____ Ft. from W. Line

			0

COMPLETE

McPherson County

Location _____

Rig up _____

Drilling and Remarks:

5" liner 2907
water 2971-73
oil 2978-85
T.D. 2998
1500' fluid
700' water
800' oil
Swab 50 oil 4 hrs.
Comp. 50 bopd
25 water

RECORD

Cased _____ in., _____ ft.

Sand _____

Gas _____

Oil _____

Total Depth _____

PRODUCTION

1st 24 hrs. Nat. _____

1st 24 hrs. after shot _____

Gas _____ Cu. Ft.

Dry Hole _____

Abandoned _____

Date

MAR 22 1950 19

J. E. TYRA

Scout