


Map No. **KANSAS** Sec. 31 Twp. 18 R. 2W

Well No. J-Clark Farm
Sinclair Oil Co. Company

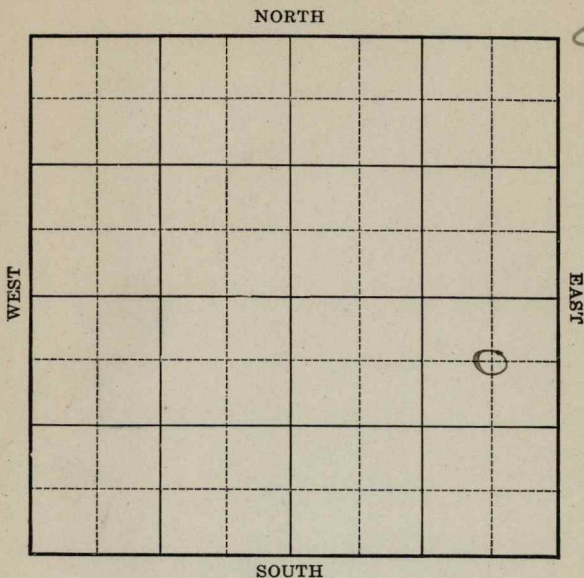

Location _____

Drilling Remarks _____

Rig Up _____

Drilling Remarks _____

RECORD

Cased _____ in. _____ ft.

Sand _____

Gas _____

Oil _____

Total Depth _____

PRODUCTION

1st 24 hrs. Nat. _____

1st 24 hrs. after shot _____

Gas _____ cu. ft.

Dry Hole _____

Abandoned _____

Map No. **KANSAS** Sec. 31 Twp. 18 R. 2W


Well No. 1-Clark Farm
Sinclair Oil Company

660 Ft. from N. Line

_____ Ft. from S. Line

660 Ft. from E. Line

_____ Ft. from W. Line

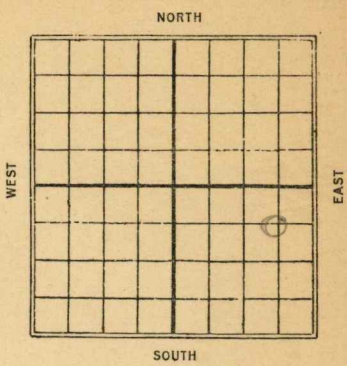

1928

Date	REPORT
4/25	Location
5/2	Rig
5/9	Rigging up-
5/16	Spud
5/23	_____
5/31	Drlg 400
6/6	Show gas 1460 - run'g 10" - 1460
6/13	Drlg 1535
6/20	T.D. 1785 - u.R. 10"
6/27	Drlg 2115
7/3	Show oil 2332 - 35-
	drilling 2385-
7/11	" 2500
7/18	Run'g 6' @ 2730
7/25	Drlg 2930
8/1	Top chat 2962 T.D. 2990
	4 1/4 # GAS
	910 # Rock Pressure

No Drilling

Map No. **KANSAS** Sec. *31* Twp. *18* R. *2W*

Well No. *1 Clark*

Sinclair O & G Company

Contractor

SECTION PLAT

			0

660 Ft. from N. Line

----- Ft. from S. Line

660 Ft. from E. Line

----- Ft. from W. Line

FIRST REPORTS

Location

Rig up -----

Drilling and Remarks:

RECORD

Cased ----- in., ----- ft.

Sand -----

Gas -----

Oil -----

Total Depth -----

PRODUCTION

1st 24 hrs. Nat. -----

1st 24 hrs. after shot -----

Gas ----- Cu. Ft.

Dry Hole -----

Abandoned -----

Date

APR 25 1928

192

S. J. LEWIS

Scout

MAP No. _____ SEC. 31 TWP. 18 S R. 7 W

WELL No. 1 Clark
Sinclair COMPANY

CONTRACTOR _____

SECTION PLAT

			○

_____ FT. FROM N. LINE

_____ FT. FROM S. LINE

_____ FT. FROM E. LINE

_____ FT. FROM W. LINE

*checked OK with
our well map*

LOCATION _____

RIG UP _____

DRILLING AND REMARKS:

*2962 } chat
2990 }
4750 M
940. R. P*

RECORD

CASED _____ IN. _____ FT.

SAND _____

GAS

OIL _____

TOTAL DEPTH 2990

PRODUCTION

1ST 24 HRS. NAT. _____

1ST 24 HRS. AFTER SHOT _____

GAS 1/4 M CU. FT.

DRY HOLE _____

ABANDONED _____

DATE

7/31 1928

SCOUT

Map No. **KANSAS** Sec. 31 Twp. 18 R. 2W

Well No. 1 Clark

Sinclair O & G. Company

Contractor

SECTION PLAT

660 Ft. from N. Line

_____ Ft. from S. Line

660 Ft. from E. Line

_____ Ft. from W. Line

			0

COMPLETED

Location _____

Rig up _____

Drilling and Remarks:

Top Chat 2962
Total Depth 2990
4 1/4 M. Gas.
910 # Rock Pt.

RECORD

Cased _____ in., _____ ft.

Sand _____

Gas _____

Oil _____

Total Depth _____

PRODUCTION

1st 24 hrs. Nat. _____

1st 24 hrs. after shot _____

Gas _____ Cu. Ft.

Dry Hole _____

Abandoned _____

Date

AUG 1 1928

S. J. LEWIS

192

Scout