


Section 31 Township 18 Range 2W

Well No. #2 Larson

Company Ray Law & Larry Moore

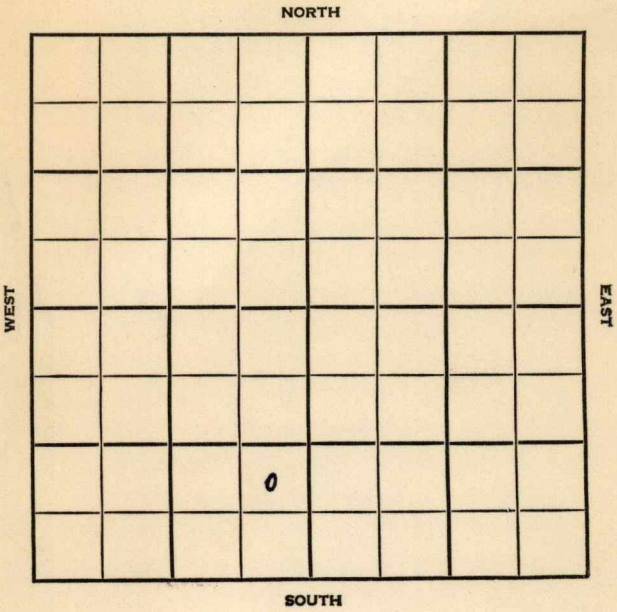

SEC.	TWP.	R.
31	18	2 W
WELL NO.		
# 2 Larson		
FARM		
COMPANY		
Ray Law & Larry Moore		
CONTRACTOR		

McPherson Pool

Ft. from N. Line

990


Ft. from S. Line

330

Ft. from E. Line

Ft. from W. Line

NE SE SW

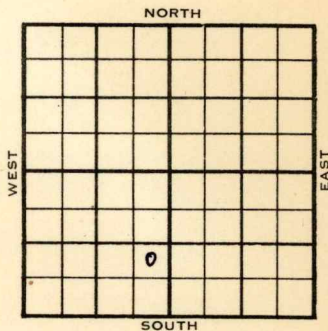

1954

ELEVATION
1549'

REPORT

9/8

Spud 9-4-54
8" @ 155'
Drlg. 1615'

10/13

Spud 9-4-54
Oil Well
TD 3009'
8" @ 155'
KC 2321', Miss 2959'
TD 3000'
5" @ 2997'
DD 3009' FU 1400' wtr.
PB 2984'
12/ 2968-71 3 bwph 3 hr.
15/ 2971-75 FU 700' wtr.
PB 2800'
15/ 2343-44 HFW CO to 2351'
18/ 2341-44 10 gwph 500 A S/ 1/2 bo
3 1/2 bw.
Comp 8 bopd. 50 bw.

COMPLETED

