

McPherson

KANSAS


Map No. _____ Sec. *32* Twp. *18* R. *2w*

Well No. *1-Benson* Farm
Mead prod Company

NORTH

12

WEST

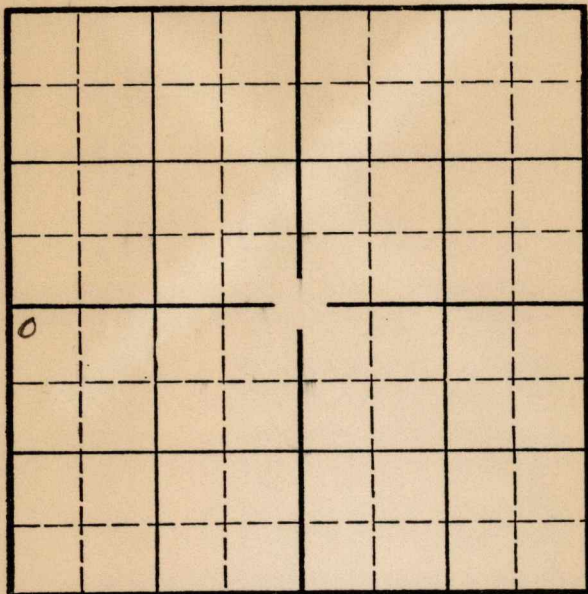

EAST

SOUTH

Location _____
Drilling Remarks _____

Rig Up _____
Drilling Remarks _____

RECORD

Cased _____ in. _____ ft.
Sand _____
Gas _____
Oil _____
Total Depth _____

PRODUCTION

1st 24 hrs. Nat. _____
1st 24 hrs. after shot _____
Gas _____ cu. ft. _____
Dry Hole _____
Abandoned _____

McPherson

Map No. KANSAS Sec. 32 Twp. 18 R. 2W


Well No. 1- Benson Farm
Mead Prod Company

330 Ft. from N. Line

_____ Ft. from S. Line

_____ Ft. from E. Line

330 Ft. from W. Line

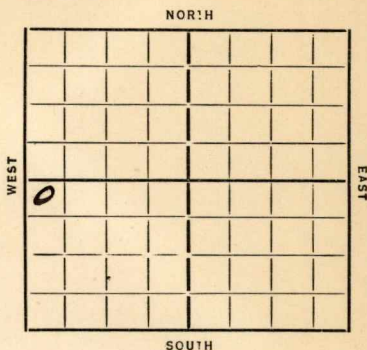

Date 7/3/5 REPORT

7/24 Cellar
8/8 Blg 1010
8/45 " 1695 10" 1462
8/22 7" 2285 W.O.C.
8/29 K.C. 2324 5" 2324
Oil 2332 2343 T1
1500 acid
9/6
10/2 K.C. 2324
T1 2343
1500 acid
361 Oil

COMPLETED

Map No. 42 Sec. 32 Twp. 18 R. 2 WWell No. 1 BensonHeard Prod. Company

Contractor

FIRST REPORTS

SECTION PLAT

330 Ft. from N. Line

..... Ft. from S. Line

..... Ft. from E. Line

330 Ft. from W. Line

0			

Location.....

Rig up.....

Drilling and Remarks:

Ce Har

RECORD

Cased..... in., ... ft.

Sand.....

Gas.....

Oil.....

Total Depth.....

PRODUCTION

1st 24 hrs. Nat.....

1st 24 hrs. after shot.....

Gas..... Cu. Ft.

Dry Hole.....

Abandoned.....

Date

7/24/35 192.....

ORVAL MANNISCHKE

Scout

Map No. 42 Sec. 32 Twp. 18 R. 2WWell No. 1-BensonMeador Company

Contractor

COMPLETED

SECTION PLAT

330 Ft. from N. Line

Ft. from S. Line

Ft. from E. Line

330 Ft. from W. Line

0			

Location

Rig up

Drilling and Remarks:

1500 and361 oil

RECORD

Cased 150 in. 2324 ft.

Sand

Gas

Oil

Total Depth 2343

PRODUCTION

1st 24 hrs. Nat.

1st 24 hrs. after shot

Gas Cu. Ft.

Dry Hole

Abandoned

Date

ORVAL MANNSCHRECK

10-2-35 192

Scout