


Section 31 Township 18 Range 2W

Well No. #1 Clark

Company A. D. Allison

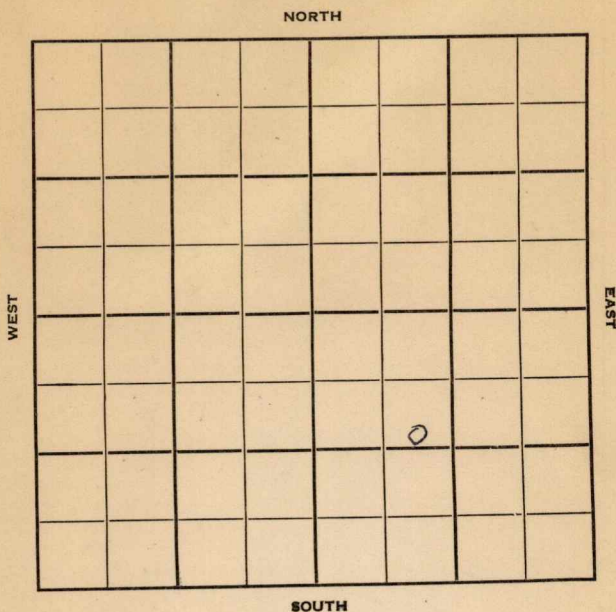

KANSAS

McPherson

Sec. 31 Twp. 18 R. 2-W

Well No. #1 Clark Farm

A. D. Allison Company

Contractor


990 Ft. from N. Line

1400' Ft. from S. Line

Ft. from E. Line

990 Ft. from W. Line

SE NW ~~NW~~
SE

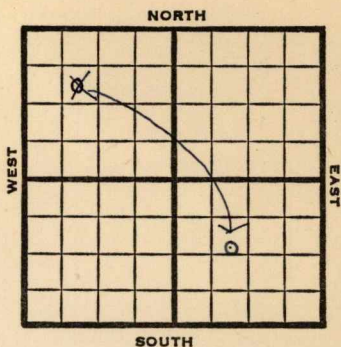

1950

Elev 1553

REPORT

6/7

Spud 6-6-50
Drlg.

7/5

8 5/8" @ 100

Miss 2936-85

5" @ 2982

TD 2996 HFW

PB 2988

500 acid SSO

5 qt 2988-91 no inc.

24/2956-64

2353-60 HFW

D&A

ABANDONED

Kansas

Map No. _____ Sec. 31 Twp. 18 R. 2WWell No. 1 ClarkA. D. Allison Company

Contractor

SE NW NW

SECTION PLAT

990 Ft. from N. Line

_____ Ft. from S. Line

_____ Ft. from E. Line

990 Ft. from W. Line

○			

FIRST REPORT

McPherson

Location _____

Rig up _____

Drilling and Remarks:

Spud 6-6-50

Drlg.

RECORD

Cased _____ in., _____ ft.

Sand _____

Gas _____

Oil _____

Total Depth _____

PRODUCTION

1st 24 hrs. Nat. _____

1st 24 hrs. after shot _____

Gas _____ Cu. Ft.

Dry Hole _____

Abandoned _____

Date

JUN 7 1950 19

J. E. TYRA

Scout

Kansas

Map No. _____ Sec. 31 Twp. 18 R. 2WWell No. 1 Clark

_____ A. D. Allison _____ Company

CORRECTION _____ Contractor


SE NW SE

El. 1553
SECTION PLAT

_____ Ft. from N. Line

1400 Ft. from S. Line

_____ Ft. from E. Line

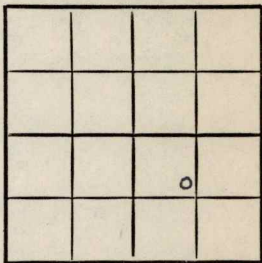990 Ft. from W. Line

McPherson County

Location _____

Rig up _____

Drilling and Remarks:

Reported

SE NW NW

RECORD

Cased _____ in., _____ ft.

Sand _____

Gas _____

Oil _____

Total Depth _____

PRODUCTION

1st 24 hrs. Nat. _____

1st 24 hrs. after shot _____

Gas _____ Cu. Ft.

Dry Hole _____

Abandoned _____

Date

JUN 14 1950

19

J. E. TYRA _____ Scout

Kansas

Map No. _____ Sec. 31 Twp. 18 R. 2WWell No. 1 Clark_____ A. D. Allison Company

_____ Contractor

SE NW SE

E1. 1553
SECTION PLAT

_____ Ft. from N. Line

1400 Ft. from S. Line

_____ Ft. from E. Line

990 Ft. from W. Line

McPherson County

Location _____

Rig up _____

Drilling and Remarks:

8 5/8" @ 100

Miss. 2936-85

5" @ 2982

TD 2996 HFW

PB 2988

500 acid SSO

RECORD

Cased _____ in., _____ ft.

Sand _____

Gas _____

Oil _____

Total Depth 2996

PRODUCTION

1st 24 hrs. Nat. _____

1st 24 hrs. after shot _____

Gas _____ Cu. Ft.

Dry Hole _____

Abandoned _____

Date JUL 5 1950J. L. TYRA Scout

5 qt. 2988-91

no inc.

24/ 2956-64

2353-60 HFW

D & A

7 1950

JUL

Scout Cards
Land Small Map
Land Wall Map
Tracings
France Map
Pierce Map
Misc.

Drilling and Remarks:

Big up

Location

Topography

Oil

Gas

Sand

Gravel

RECORD






Contractor

Company

Well No

Map No

Sec

Twp

R