

Barton

KANSAS

Section 24 Township 20 Range 11WWell No. #24 H.J. RoetzelCompany Magnolia Pet.

NORTH

						0	

WEST

EAST

SOUTH

Barton

KANSAS

SEC.	TWP.	R.
24	20	11W

WELL NO.

#24 H.J. Roetzel

FARM

COMPANY

MagnoliaPet.

CONTRACTOR

S. Silica Pool


NORTH

Ft. from N. Line

990 Ft. from S. Line

990 Ft. from E. Line

Ft. from W. Line

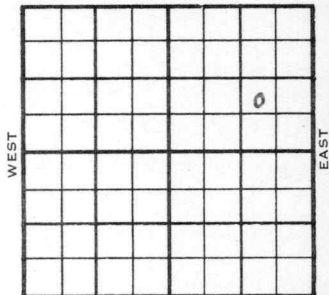

NW SE NE


	ELEVATION	REPORT
1953	1748'	

11/4	Location
11/11	"
11/18	8" @ 242' Drlg. 2175'
12/16	Spud 11-12-53 Oil Well TD 3252' 8" @ 242' Heeb 2839', Lans 2988', Arb. 3246' TD 3251' 5" @ 3251' DD 3252' S/198 bo 54 bw 18 hrs. P/56 bo 10 bw 7 hrs. P/90 bo 20 bw 10 hrs. Comp. 124 bopd 50% wtr.

COMPLETED

J. G. McGEHEE

County Barton State Kansas
 Sec. 24 (Blk. 20 (Sur. 11W Map No.
 (Twp.) (Rge.)
 Operator Magnolia Pet.
 Well No. 24 Farm H. J. Roetzel
 Elev. 1748 Location NW SE NE

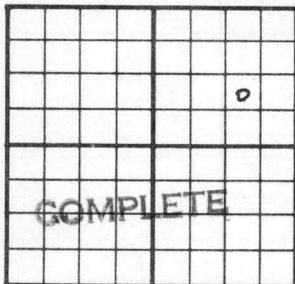

990 Ft. From S Line NE
 990 Ft. From E Line Quarter
 1st. Report
 Completion DEC 16 1953
 Remarks S. Silica Pool

Spudding Date 11-12-53

Drlg. Data Oil well TD 3252

8" @ 242 Heeb. 2839 Lans. 2988

Arb. 3246 TD 3251 5" @ 3251 DD 3252

S/ 198 bo 54 bw 18 hr. P/ 56 bo

10 bw 7 hr. P/ 90 bo 20 bw 10 hr.

Comp. 124 bopd 50% wtr.