


Map No. *2-31* Sec. *31* Twp. *18* R. *2W*
Well No. *Palmer itab* Farm _____ Company _____

NORTH

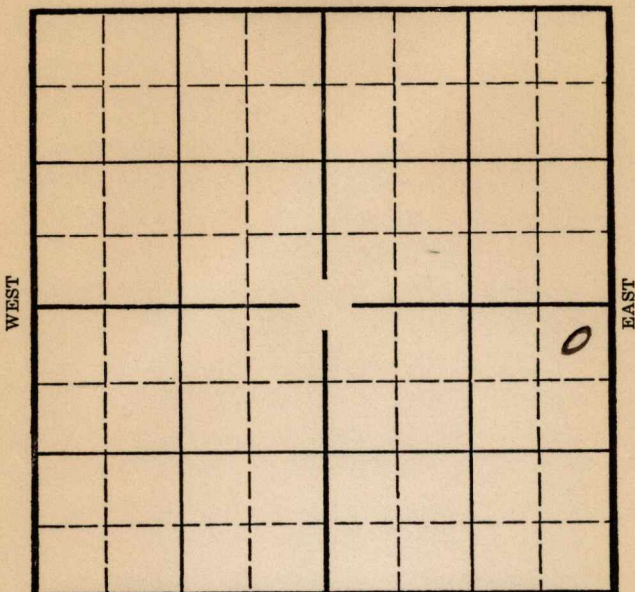

SOUTH

Location _____
Drilling Remarks _____

Rig Up _____
Drilling Remarks _____

RECORD

Cased _____ in. _____ ft.
Sand _____
Gas _____
Oil _____
Total Depth _____

PRODUCTION

1st 24 hrs. Nat. _____
1st 24 hrs. after shot _____
Gas _____ cu. ft. _____
Dry Hole _____
Abandoned _____

Mc Pherson

Map No. **KANSAS** Sec. **31** Twp. **18** R. **2^w**
Well No. **2- Clark** Farm
Palmer et al Company


330 Ft. from N. Line

Ft. from S. Line

330 Ft. from E. Line

Ft. from W. Line

Elev. 1559

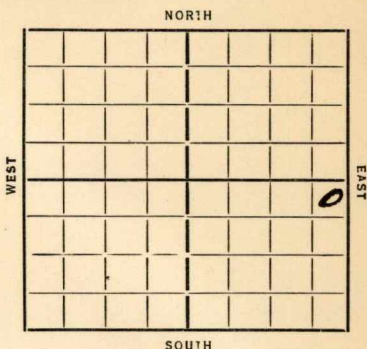

Date **7/35**

REPORT

7/11 Location
7/18 100 rd
8/8 K C 2318 5" 2318
8/15 Pay 2333-34 1200' oil
2340 1000 acid
8/22 1 Bbl oil per hr.
8/28 K C 2319
T D 2340
1000 acid
65 Bbls.

COMPLETED

KANSAS

Map No. 42 Sec. 31 Twp. 18 R. 2WWell No. 2-ClarkPalmer et al Company

Contractor

FIRST REPORTS

SECTION PLAT

330 Ft. from N. Line

Ft. from S. Line

330 Ft. from E. Line

Ft. from W. Line

			0

Location ✓

Rig up

Drilling and Remarks:

RECORD

Cased in, ft.

Sand

Gas

Oil

Total Depth

PRODUCTION

1st 24 hrs. Nat.

1st 24 hrs. after shot

Gas Cu. Ft.

Dry Hole

Abandoned

Date

7-11-35 192 Scout

ORVAL MANNSCHRECK

Map No. 48 Sec. 31 Twp. 18 R. 2^W

Well No. 2-Clark

Palmer et al Company

Contractor

COMPLETED

SECTION PLAT

330 Ft. from N. Line

..... Ft. from S. Line

330 Ft. from E. Line

..... Ft. from W. Line

			0

Location

Rig up

Drilling and Remarks: .

1000 and

65 lbs

RECORD

Cased in., ... ft.

Sand 5C 2319

Gas

Oil

Total Depth 2340

PRODUCTION

1st 24 hrs. Nat.

1st 24 hrs. after shot

Gas Cu. Ft.

Dry Hole

Abandoned

Date

8-28-35 192

ORVAL MANNSCHRECK

Scout