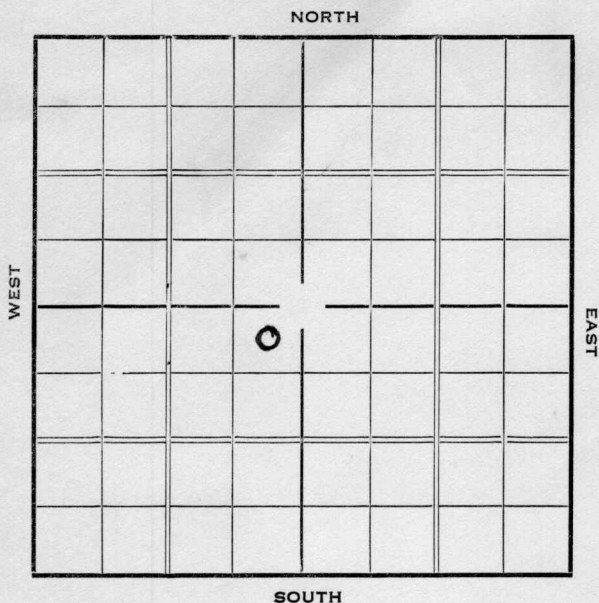



Barton

KANSAS

Section 24 Township 20 Range 11-WWell Number 1 SesslerCompany Gulf

Sec. 24 Twp. 20 R. 11-WWell No. #1 Sessler FarmGulf Company330 Ft. from N. Line Ft. from S. Line330 Ft. from E. Line Ft. from W. Line

Elev. 1751

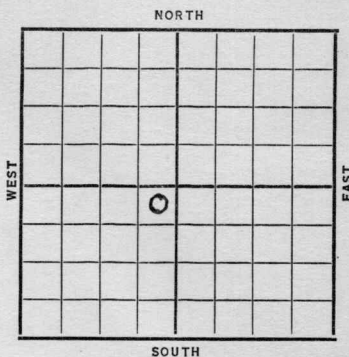

Date

REPORT

1937

5/5

Location

5/14

Rig

5/21

12" @ 166'. Drlg. 1640'.

5/28

Drlg. 3180'.

6/4

Sil. 3243' & 6".

Drlg. 3250'. H.F.O.

6/11

T.D. 3253'. Flowed 276 in
6 hrs. thru casing.

6/19

Pot. 1640 bbls. 24 hrs.

4000 acid.

6/23

6" @ 3243'.

Sil. 3243'.

T.D. 3253'.

4000 acid.

Pot. 2216 bbls.

COMPLETED

Barton KANSAS

Map No. 46 Sec. 24 Twp. 20 R. 11 WWell No. 1 - SesslerGulf Company

Contractor

FIRST REPORT**SECTION PLAT**

	0		

330 Ft. from N. Line

_____ Ft. from S. Line

330 Ft. from E. Line

_____ Ft. from W. Line

FIRST REPORTLocation ✓

Rig up _____

Drilling and Remarks:

RECORD

Cased _____ in., _____ ft.

Sand _____

Gas _____

Oil _____

Total Depth _____

PRODUCTION

1st 24 hrs. Nat. _____

1st 24 hrs. after shot _____

Gas _____ Cu. Ft.

Dry Hole _____

Abandoned _____

Date

MAY 5 - 1937

19

R. D. Hatfield Seout

Barton KANSASMap No. *46* Sec. *24* Twp. *20* R. *11 W*Well No. *1-Lessler**Gulf* Company

Contractor

COMPLETED

SECTION PLAT

	0		

330 Ft. from N. Line

_____ Ft. from S. Line

330 Ft. from E. Line

_____ Ft. from W. Line

Location _____

Rig up _____

Drilling and Remarks:

*4000 Acid**Pat 2216*

RECORD

Cased *6* in. *3243* ft.~~Sand~~ *511 3243*

Gas _____

Oil _____

Total Depth *3253*

PRODUCTION

1st 24 hrs. Nat. _____

1st 24 hrs. after shot _____

Gas _____ Cu. Ft.

Dry Hole _____

Abandoned _____

Date

JUN 23 1937

19

H. D. Hatfield Scout