


McPherson

Form 51-5M-2-29-34703

Map No. **KANSAS** Sec. *31* Twp. *18* R. *2^w*

Well No. *2 - Larson* Farm
Mid-Kansas Oil & Gas Company

NORTH

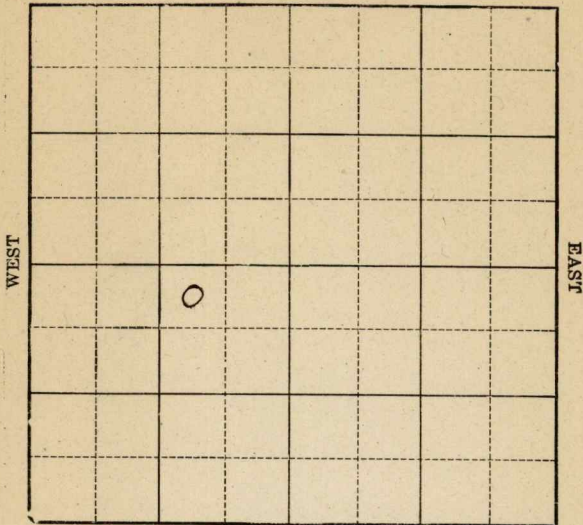

11

SOUTH

Location _____

Drilling Remarks _____

Rig Up _____

Drilling Remarks _____

RECORD

Cased _____ in. _____ ft.

Sand _____

Gas _____

Oil _____

Total Depth _____

PRODUCTION

1st 24 hrs. Nat. _____

1st 24 hrs. after shot _____

Gas _____ cu. ft.

Dry Hole _____

Abandoned _____

Map No. **KANSAS** Sec. 31 Twp. 18 R. 2^w


Well No. 2-Larson Farm
Mid-Kansas Oil Company

330 Ft. from N. Line

_____ Ft. from S. Line

990 Ft. from E. Line

_____ Ft. from W. Line

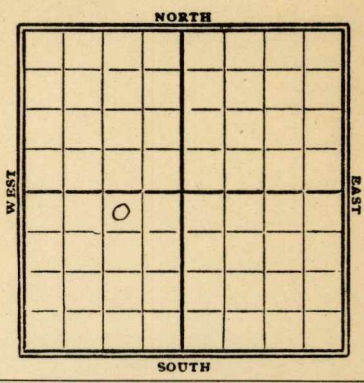

1929

Date	REPORT
3/20	Bldg Rig
3/27	Rgn up.
4/3	—
4/10	—
4/17	—
4/24	Rgd up 450
5/1	Spud
5/8	—
5/14	only 450'
5/21	" 1400'
5/29	fsq bailer 1460'
6/5	—
6/12	T.D. 1470-00
6/19	—
6/26	1680 fsq collapsed 12"
7/2	—
7/10	—
7/17	—
7/24	Skid rig 35' east
7/31	Spudding
8/7	Only 410'
8/14	" 980'

1927
8/21 - T.D. 1000' S.D.
8/28 - _____
9/4 - Wlg 1070
9/11 - S.D. 1070
9/18 - _____
9/25 - Wlg 1320
10/2 - VIR 10" - 1872'
10/9 - No report
10/16 - Wlg 2310
10/23 - " 2455'
10/30 - " 2520'
11/6 - VIR 8" - 2730'
11/13 - _____
11/20 - Wlg 2843
11/27 - " 2920
12/4 - chat 2963 - 3005
35 bbls oil 2990 - 95
HFW 3014 Wlg 3050
12/11 - Wlg 3145'
12/18 - " 3245'
12/23 - VIR 5" - 3355'
12/30 - Wlg 3355'
1930
1/8 - " 3375'
1/15 - VIR 5" - 3390'
1/22 - Top Viola 3390
HFW 3410 - 12'
S.D. 3438' T.D.
1/29 - sand 3473 - 80'
HFW 3475'
T.D. 3480'
Dry & Abandon

MAP No. **KANSAS** SEC. 31 TWP. 18 R. 2W

WELL No. 2 Larson

Mid-Kansas Oil & G. COMPANY

CONTRACTOR

SECTION PLAT

	0		

330 FT. FROM N. LINE

FT. FROM S. LINE

990 FT. FROM E. LINE

FT. FROM W. LINE

FIRST REPORTS

LOCATION _____

RIG UP _____

DRILLING AND REMARKS:

Building rig

RECORD

CASED _____ IN., _____ FT.

SAND _____

GAS _____

OIL _____

TOTAL DEPTH _____

PRODUCTION

1ST 24 HRS. NAT. _____

1ST 24 HRS. AFTER SHOT _____

GAS _____ CU. FT.

DRY HOLE _____

ABANDONED _____

DATE

MAR 20 1929

S. J. LEWIS

W. Sperry

Map No. **KANSAS** Sec. *31* Twp. *18* R. *2W*

42
Well No. *2 Larson*

Mid-Kansas O & G Company

Contractor

SECTION PLAT

330 Ft. from N. Line

..... Ft. from S. Line

990 Ft. from E. Line

..... Ft. from W. Line

	<i>0</i>		

ABANDONED

Location.....

Rig up.....

Drilling and Remarks:

AFW 3475

RECORD

Cased..... in., ft.

Sand *3473-80*

Gas.....

Oil.....

Total Depth *3480*

PRODUCTION

1st 24 hrs. Nat.....

1st 24 hrs. after shot.....

Gas..... Cu. Ft.

Dry Hole.....

Abandoned.....

Date

JAN 29 1930

192.....

S. J. LEWIS

Scout