

KANSAS McPherson

2W ✓

Sec. 32 Twp. B R. _____

Well No. #4 Benson Farm _____

Meade Prod.

Company _____

McPherson Pool (Aussman & Sons, ^{Cont.})

NORTH


_____ Ft. from N. Line

990' Ft. from S. Line

_____ Ft. from E. Line

330' Ft. from W. Line

NW SW SW

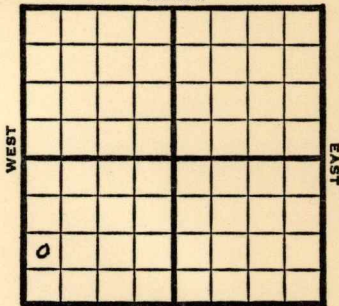

SOUTH

1949

REPORT

6/22 8" @ 115'
 Drlg. 2145'
 6/29 TD 2360'
KC 2347'
 5 @ 2345'
 3000 acid
 Pump 20 oil Pot
 36° Gr.
 Comp
COMPLETED

Kansas

Map No. _____ Sec. 32 Twp. 18 R. 2W

Well No. 4 Benson

Meade Prod. Company

Aussman & Sons Contractor

NW SW SW

FIRST REPORT
SECTION PLAT

_____ Ft. from N. Line

990 Ft. from S. Line

_____ Ft. from E. Line

330 Ft. from W. Line

o			

McPherson County

RECORD

Location _____

Cased _____ in., _____ ft.

Rig up _____

Sand _____

Drilling and Remarks:

Gas _____

8" @ 115

Oil _____

drlg. 2145

Total Depth _____

PRODUCTION

1st 24 hrs. Nat. _____

1st 24 hrs. after shot _____

Gas _____ Cu. Ft.

Dry Hole _____

Abandoned _____

Date

JUN 22 1949

19

S. J. LEWIS

Scout

