Form 51—5M—3-35—Mid-West

KANSAS

Map No. ____ Sec. 32 Twp. 18 R. 2W


Well No. 1 Grindberg Farm

McPherson D & G Company

McPherson

5

NORTH

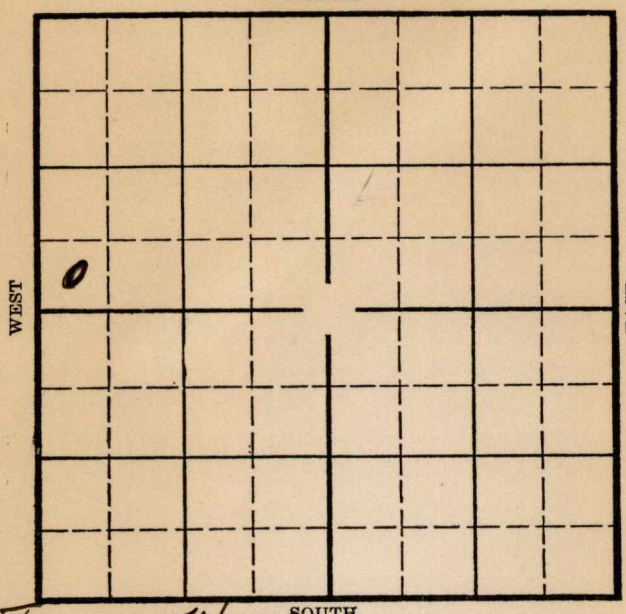

TWIN WELL

Location ____

Drilling Remarks

Rig Up ____

Drilling Remarks

RECORD

Cased ____ in. ____ ft.

Sand ____

Gas ____

Oil ____

Total Depth ____

PRODUCTION

1st 24 hrs. Nat. ____

1st 24 hrs. after shot ____

Gas ____ cu. ft. ____

Dry Hole ____

Abandoned ____


Form 252-A
5M 7-34 MPC

McPherson

Map No. KANSAS Sec. 37 Twp. 18 R. 2W

Well No. 1 - Chindberg Farm

McPherson O & G. Company

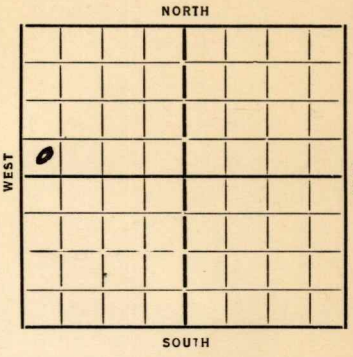

____ Ft. from N. Line

330 Ft. from S. Line

____ Ft. from E. Line

330 Ft. from W. Line

Twin

Date	Elevation 1559 REPORT
1935	
6/17	Moving In
6/20	—
6/28	Spud 15" 145
7/3	Dlg 985 13" 455
7/11	1400 sh
7/18	Dlg 1715
8/1	KC 2314 6" 2314
	Oil 2320 TJ 2324
	2000 Oil acidized
8/8	10 Bbls per hr.
8/14	KCL 2314
	TJ 2324
	1000 acid
	230 Bbls.
	COMPLETED

KANSAS

Form 26—1M Bks. 3-28

McPherson

Map No. 42 Sec. 32 Twp. 18 R. 2W


Well No. 1 — Chindberg

McPherson Oil Co. Company

Contractor

FIRST REPORTS

SECTION PLAT

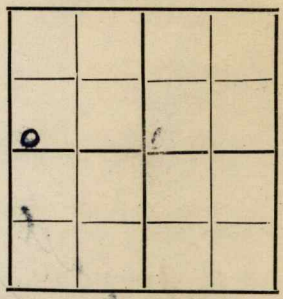

.....Ft. from N. Line

330 Ft. from S. Line

.....Ft. from E. Line

330 Ft. from W. Line

Twin Well

Location.....

Rig up.....

Drilling and Remarks:

Moving in

RECORD

Cased.....in., ...ft.

Sand.....

Gas.....

Oil.....

Total Depth.....

PRODUCTION

1st 24 hrs. Nat.....

1st 24 hrs. after shot.....

Gas.....Cu. Ft.

Dry Hole.....

Abandoned.....

Date

6-12-35 192....

ORVAL MANNSCHRECK

.....Scout

Form 26—1M Blks.—8-28

McPherson KANSAS

Map No. 42 Sec. 32 Twp. 18 R. 2W


Well No. 1- Chindberg

McPherson O & G Company

Contractor

COMPLETED

SECTION PLAT

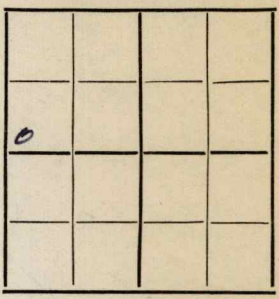

Ft. from N. Line

330 Ft. from S. Line

Ft. from E. Line

330 Ft. from W. Line

Location

Rig up

Drilling and Remarks:

1000 and

230 bbls

RECORD

Cased in., ft.

~~Sand~~ KCL 2314

Gas

Oil

Total Depth 2324

PRODUCTION

1st 24 hrs. Nat.

1st 24 hrs. after shot

Gas Cu. Ft.

Dry Hole


Abandoned

Date

8-14-35 192

ORVAL MANNSCHRECK Scout

We show a dry hole at this
location depth 3456'
Check and Advise
Thanks
Sam

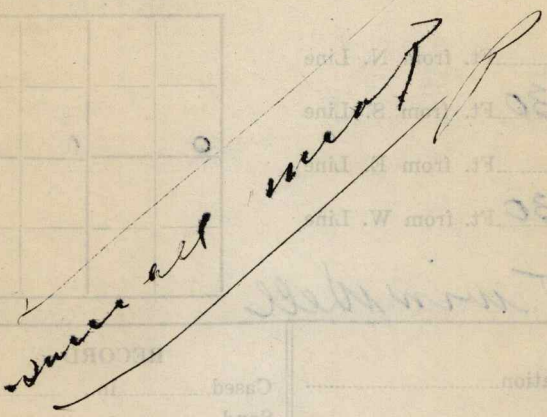

Returned
Cards
Tracing
France Map
Scarborough Map
Moody Map
Scarborough Plat Book
Moody Plat Book