Form 51-5M-10-36 Com'l


Barton

KANSAS

Section 24 Township 20 Range 11-W

Well Number 1 Peters

Company I.T.I.O.

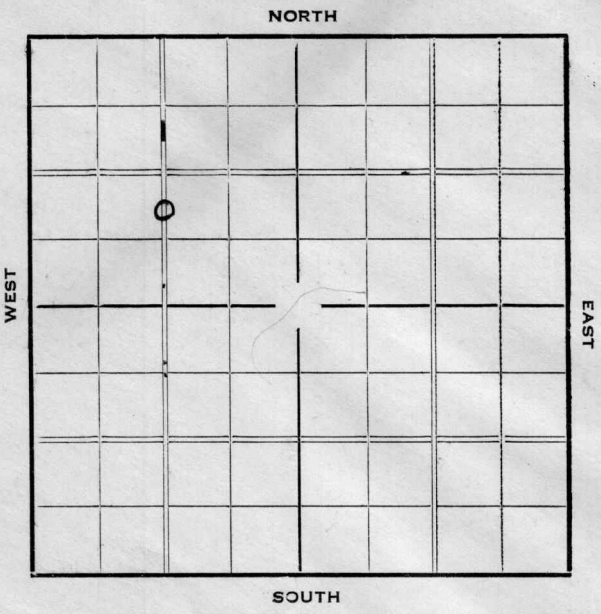


Form 252-A—5M—7-36—Palace KANSAS Barton

Sec. 24 Twp. 20 R. 11-W

Well No. #1 Peters Farm

I. T. I. O. Company

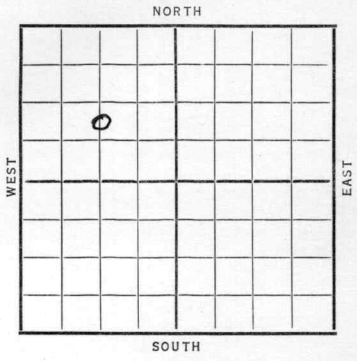

_____ Ft. from N. Line

990 Ft. from S. Line

1320 Ft. from E. Line

_____ Ft. from W. Line

Elev. 1752

Date 1936	REPORT
11/18	Location
11/27	12" @ 214'. WOC.
12/3	Drlg. 2400'.
12/10	Sil 3248' set 7". T. D. 3250' RUST.
12/17	T. D. 3255'. Hole full oil.
12/22	Sil. 3248'. T. D. 3258'. Pot. 1964.
	COMPLETED

Form 26—1M-Bks.—2-29

Barton KANSAS


Map No. 46 Sec. 24 Twp. 20 R. 11W

Well No. 1 Peters

S. T. L. O. Company

Contractor

SECTION PLAT

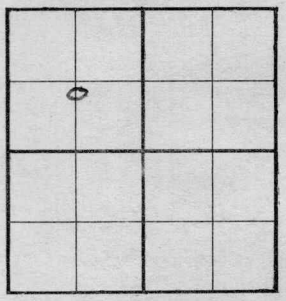

_____ Ft. from N. Line

990 Ft. from S. Line

1320 Ft. from E. Line

_____ Ft. from W. Line

FIRST REPORT

Location ✓

Rig up

Drilling and Remarks:

RECORD

Cased _____ in., _____ ft.

Sand

Gas

Oil

Total Depth

PRODUCTION

1st 24 hrs. Nat.

1st 24 hrs. after shot

Gas _____ Cu. Ft.

Dry Hole

Abandoned

Date

NOV 18 1936 19

S. J. LEWIS Scout

Form 26 1M Blks. 2-29 Barton KANSAS


Map No. 46 Sec. 24 Twp. 20 R. 11W

Well No. 1 Peters

I. T. L. C. Company

Contractor

SECTION PLAT

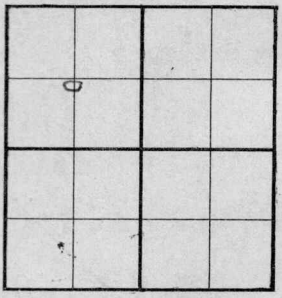

____ Ft. from N. Line

990 Ft. from S. Line

1320 Ft. from E. Line

____ Ft. from W. Line

COMPLETED

Location

Rig up

Drilling and Remarks:

Si 3248.

P & A 1964

RECORD

Cased ____ in., ____ ft.

Sand

Gas

Oil

Total Depth 3258

PRODUCTION

1st 24 hrs. Nat.

1st 24 hrs. after shot

Gas ____ Cu. Ft.

Dry Hole

Abandoned

Date

DEC 22 1936 19

S. J. LEWIS Scout