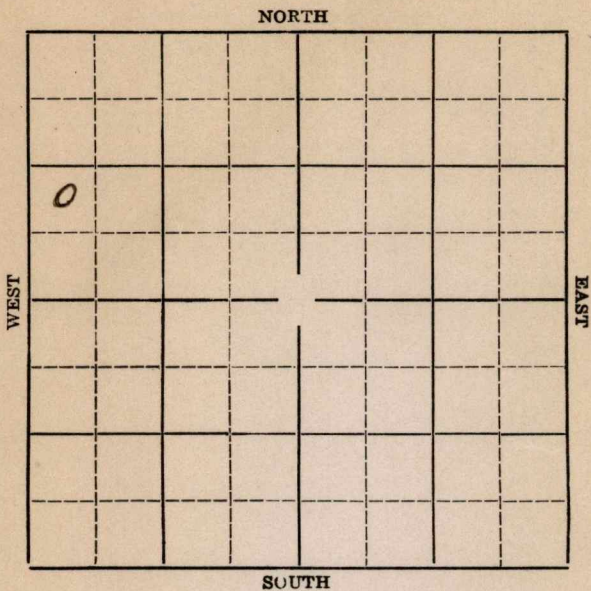


Section 32 Township 18 Range 2-WWell Number k-4 ChingbergCompany McPherson O & G

Map No. Sec. 32 Twp. 18 R. 2W

Well No. #K-4 Chingberg Farm

McPherson Oil and Gas. Company


 Ft. from N. Line

990' Ft. from S. Line

 Ft. from E. Line

330' Ft. from W. Line

Elev. 1559

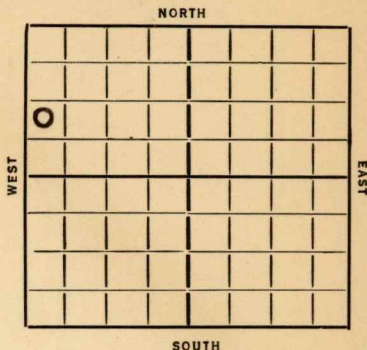

Date	REPORT
19 <u>86</u>	
5/13	Pond.
5/21	Rigging up.
5/28	Drlg. 1035'.
6/4	Drlg. 1830'.
6/11	K.C. 2307'. Set 5" Wait on cement.
6/24/36	-K.C.Lime 2307'.
	2000 gallons acid.
	T.D. 2331'.
	Pump 224 bbls oil.

COMPLETED

KANSAS

Map No. 42 Sec. 32 Twp. 18 R. 2WWell No. K-4 ChungbergW. C. Pherson & Co. Company

Contractor

SECTION PLAT

0			

_____ Ft. from N. Line

990 Ft. from S. Line

_____ Ft. from E. Line

330 Ft. from W. Line

FIRST REPORT

Location _____

Rig up _____

Drilling and Remarks:

Ponds

RECORD

Cased _____ in., _____ ft.

Sand _____

Gas _____

Oil _____

Total Depth _____

PRODUCTION

1st 24 hrs. Nat. _____

1st 24 hrs. after shot _____

Gas _____ Cu. Ft.

Dry Hole _____

Abandoned _____

Date

MAY 13 1936

19

S. J. LEWIS

Scout

KANSAS

Map No. 42 Sec. 32 Twp. 18 R. 2WWell No. K-4 ChindlerW. Pherson D & S Company

Contractor

SECTION PLAT

0			

Ft. from N. Line

990 Ft. from S. Line

Ft. from E. Line

330 Ft. from W. Line

COMPLETED

Location

Rig up

Drilling and Remarks:

KC Line 23072000 aciolPump 224

RECORD

Cased _____ in., _____ ft.

Sand _____

Gas _____

Oil _____

Total Depth 2331

PRODUCTION

1st 24 hrs. Nat. _____

1st 24 hrs. after shot _____

Gas _____ Cu. Ft.

Dry Hole _____

Abandoned _____

Date

JUN 24 1936

19

S. J. LEWIS

Scout