

Well No. 1 Flowy Farm

2 Ploug Farm
Shell Bst. et al Company

WEST

EAST

SOUTH

Rig Up

Drilling Remarks

PRODUCTION

1st 24 hrs. Nat.-----

1st 24 hrs. after shot_____

Gas _____ cu. ft. _____

Dry Hole_____


Abandoned_____

Rice

Map No. KANSAS Sec. 33 Twp. 18 R. 9W

Well No. 2 Ploog Farm
Shell Pitt et al Company

NORTH

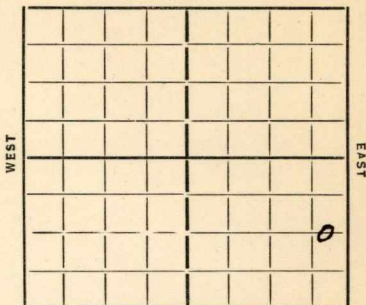

 Ft. from N. Line

1320 Ft. from S. Line

440 Ft. from E. Line

 Ft. from W. Line

SOUTH

Date 1934

REPORT

8/29 Rig
9/6 — 9/13 — 9/20 — 9/27 —
10/4 Dly 425 20" 187
10/11 " 1125
10/18 " 1765 15" 485 12" 1547
10/25 2180 51)
11/1 2370 20" 10"
11/8 Dly 2945 A.O. 2940-42
11/15 K.C.L. 2900 A.O. 2994-95
8" 3127 6" 3239 C.O.
11/22 Siliceous 3270 T.D. 3272
Swab 405 Bbls oil 15 Water
17 1/2 hrs.
11/28 Pump 285 oil & 23 w 24 hrs.
May acidize
12/6 —
12/12 Siliceous 3270 T.D. 3272
285 oil 23 Water

COMPLETED

KANSAS

Map No. 45 Sec. 33 Twp. 18 R. 9WWell No. 2-2-1000Company Shell pet. etal

Contractor _____

FIRST REPORTS

SECTION PLAT

			0

_____ Ft. from N. Line

1320 Ft. from S. Line440 Ft. from E. Line

_____ Ft. from W. Line

Location _____

Rig up _____

Drilling and Remarks:

Rig

RECORD

Cased _____ in., _____ ft.

Sand _____

Gas _____

Oil _____

Total Depth _____

PRODUCTION

1st 24 hrs. Nat. _____

1st 24 hrs. after shot _____

Gas _____ Cu. Ft.

Dry Hole _____

Abandoned _____

Date

8-29-34

19

ORVAL MANNSCHRECK

Scout

Map No. 45 Sec. 33 Twp. 18 R. 9WWell No. 2-PlongShill et al Company

Contractor

COMPLETED

SECTION PLAT

Ft. from N. Line

1320 Ft. from S. Line440 Ft. from E. Line

Ft. from W. Line

			0

Location

Rig up

Drilling and Remarks:

285 oil
23 water

RECORD

Cased _____ in., _____ ft.

Sand silicums 3270

Gas _____

Oil _____

Total Depth 3272

PRODUCTION

1st 24 hrs. Nat. _____

1st 24 hrs. after shot _____

Gas _____ Cu. Ft.

Dry Hole _____

Abandoned _____

Date

12-12-37 192 _____ Scout

ORVAL MANNSCHRECK