




Rice

Map No. **KANSAS** Sec. **33** Twp **18** R. **9W**

Well No. **3 Ploog** Farm  
**Shell et al** Company

\_\_\_\_\_ Ft. from N. Line  
**1320** Ft. from S. Line  
**440** Ft. from E. Line  
\_\_\_\_\_ Ft. from W. Line

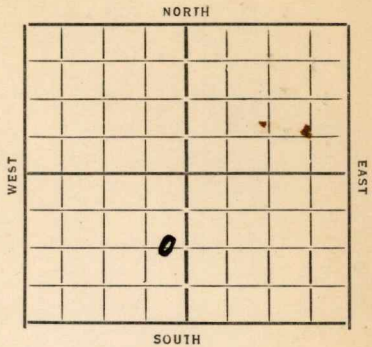

Date

REPORT

**1952**  
**12/26** Moving  
**1/3/35** Rig Rot  
**1/19** dly 740  
**1/17** " 1956  
**1/24** " 2780  
**1/31** " 3178 T.C. 2883  
S.O. 2946-48.  
**2/7** Siliceous 3216 T 7 3221  
Some saturation  
**2/14** Swab 255 Bbls 5 hrs.  
Tubing  
**2/20** Siliceous 3216 T 7 3221  
974 Bbls.

COMPLETED

Map No. 45 Sec. 33 Twp. 18 R. 9W

Well No. 3-floog

Shell et al Company

Contractor

FIRST REPORTS

SECTION PLAT

..... Ft. from N. Line

1320 Ft. from S. Line

440 Ft. from E. Line

..... Ft. from W. Line


Location.....

Rig up.....

Drilling and Remarks:

*moving*

RECORD

Cased..... in., ..... ft.

Sand.....

Gas.....

Oil.....

Total Depth.....

PRODUCTION

1st 24 hrs. Nat.....

1st 24 hrs. after shot.....

Gas..... Cu. Ft.

Dry Hole.....

Abandoned.....

Date

12-26-34 192

ORVAL MANNSCHRECK Scout

Map No. \_\_\_\_\_ Sec. 33 Twp. 18 R. 9W


Well No. \_\_\_\_\_

*Ploog Lease*

Company

Contractor

SECTION PLAT

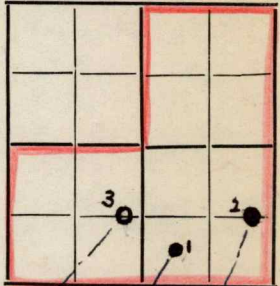

\_\_\_\_\_ Ft. from N. Line

\_\_\_\_\_ Ft. from S. Line

\_\_\_\_\_ Ft. from E. Line

\_\_\_\_\_ Ft. from W. Line

Location \_\_\_\_\_

Rig up \_\_\_\_\_

Drilling and Remarks:

*1320 S.  
440 E.*

RECORD

Cased \_\_\_\_\_ in., \_\_\_\_\_ ft.

Sand \_\_\_\_\_

Gas *660 S*

Oil *660 W 1320 S*

Total Depth *440 E*

PRODUCTION

1st 24 hrs. Nat. \_\_\_\_\_

1st 24 hrs. after shot \_\_\_\_\_

Gas \_\_\_\_\_ Cu. Ft.

Dry Hole \_\_\_\_\_

Abandoned \_\_\_\_\_

*Lease ownership*

*Shell pet. .... 1/4*

*Carter oil .... 1/4*

*Empire oil .... 1/4*

*Tatlock .... 1/8*

*J. A. Hull .... 1/8*

Date *Shell operates.*

ORVAL MANNSCHRECK

Map No. 45 Sec. 33 Twp. 18 R. 9W

Well No. 3-plong

shell pit etal Company

**KANSAS**

Contractor

**COMPLETED**

**SECTION PLAT**

..... Ft. from N. Line

1320 Ft. from S. Line

440 Ft. from E. Line

..... Ft. from W. Line


Location.....

Rig up.....

Drilling and Remarks:

974 bbls

**RECORD**

Cased..... in., ..... ft.

Sand Silicon 3216

Gas.....

Oil.....

Total Depth 3221

**PRODUCTION**

1st 24 hrs. Nat.....

1st 24 hrs. after shot.....

Gas..... Cu. Ft.

Dry Hole.....

Abandoned.....

**ORVAL MANNSCHRECK**

Date

2-20-35 192.....

Scout

There is a #1 & #2 on this  
Map does not show any other Shell  
wells in this vicinity except a #1  
oil well 1320 S. 440 E in the SE 1/4 of 33.

Woods  
Engineering Dept.

advise  
Gann

*[Large handwritten signature/initials]*

Returned	<del>_____</del>
Cards	<del>_____</del>
Tracing	<del>_____</del>
France Map	<del>_____</del>
Sea Borough Map	<del>_____</del>
Moody Map	<del>_____</del>
Scarborough Book	<del>_____</del>
Moody Plat Book	<del>_____</del>

*[Handwritten signature/initials over the stamp]*

*[Faint handwritten text]*

Date

*[Faint handwritten text]*