Form 51-5M 5-37 Petrol

Barton

KANSAS

Section 25 Township 20 Range 11-W

Well No. 4 - Bryant

Company I.T.I,O.

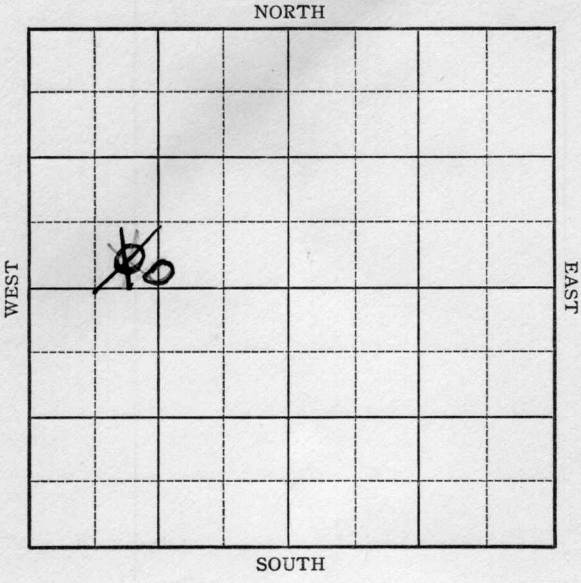

Form 252-A—5M—2-37—Palace Barton KANSAS

Sec. 25 Twp. 20 R. 11-W

Well No. #4 Bryant Farm

T.T.I.O. Company

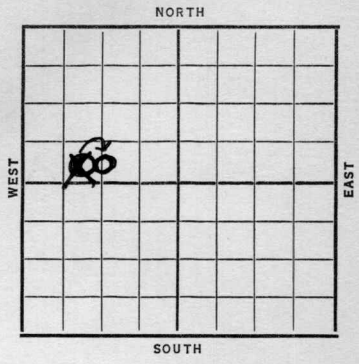

____ Ft. from N. Line

330 Ft. from S. Line

____ Ft. from E. Line

1320 ~~990~~ Ft. from W. Line

Elev. 1754

Date	REPORT
1937	
8/4	Location
8/13	10" @ 187'. WOC.
8/20	Drlg. 2970'.
8/28	Sil. 3274 & 7".
	T.D. 3279'. C.O.
9/1	7" @ 3274'.
	Sil. 3274'.
	T.D. 3305'.
	2000 acid.
	Pot. 1418 bbls. Pumped.
	COMPLETED

Form 26—1M Bks.—2-29 Barton KANSAS

Map No. _____ Sec. 25 Twp. 20 R. 11 W

Well No. 4- Bryant

I. F. P. C. Company

_____ Contractor

FIRST REPORT

_____ Ft. from N. Line

330 Ft. from S. Line

_____ Ft. from E. Line

990 Ft. from W. Line

SECTION PLAT

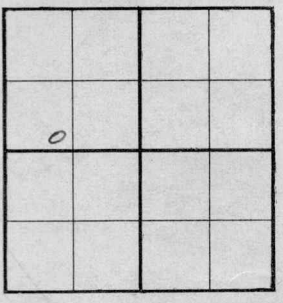

Location ✓

Rig up _____

Drilling and Remarks:

RECORD

Cased _____ in., _____ ft.

Sand _____

Gas _____

Oil _____

Total Depth _____

PRODUCTION

1st 24 hrs. Nat. _____

1st 24 hrs. after shot _____

Gas _____ Cu. Ft.

Dry Hole _____

Abandoned _____

Date

AUG 4 - 1937 19 H. D. Hatfield Scout

Form 26—1M Bks.—2-29

Barton KANSAS

Map No. Sec. 25 Twp. 20 R. 11 W

Well No. 4 - Bryant

I. F. Co. Company

Contractor

COMPLETED

Ft. from N. Line

350 Ft. from S. Line

Ft. from E. Line

1320 Ft. from W. Line

SECTION PLAT

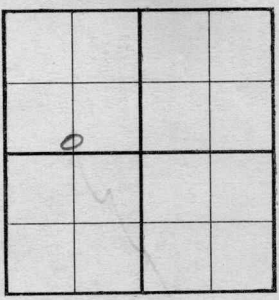

Location

Rig up

Drilling and Remarks:

2000 acid

Pot - 1418

Pumped

RECORD

Cased 7 in., 3274 ft.

Sand Sil 3274

Gas

Oil

Total Depth 3305

PRODUCTION

1st 24 hrs. Nat.

1st 24 hrs. after shot

Gas Cu. Ft.

Dry Hole

Abandoned

Date

SEP 1 1937 19

H. D. Hatfield Scout

Form 26—1M Bks.—2-29 Barton KANSAS

Map No. _____ Sec. 25 Twp. 20 R. 11 W

Well No. 4 - Bryant

I. T. Co. Company

Contractor

CORRECTION

_____ Ft. from N. Line

330 Ft. from S. Line

_____ Ft. from E. Line

1320 Ft. from W. Line

SECTION PLAT

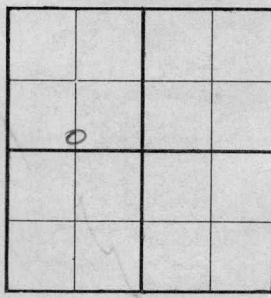

Location _____

Rig up _____

Drilling and Remarks:

first reported as SE SW NW should have been C SE NW

RECORD

Cased _____ in., _____ ft.

Sand _____

Gas _____

Oil _____

Total Depth _____

PRODUCTION

1st 24 hrs. Nat. _____

1st 24 hrs. after shot _____

Gas _____ Cu. Ft.

Dry Hole _____

Abandoned _____

Date

SEP 1 1937 19 _____

H. D. Hatfield Scout