


Section 24 Township 20 Range 11-W

Well Number 6 - H. Peters

Company Lario et al

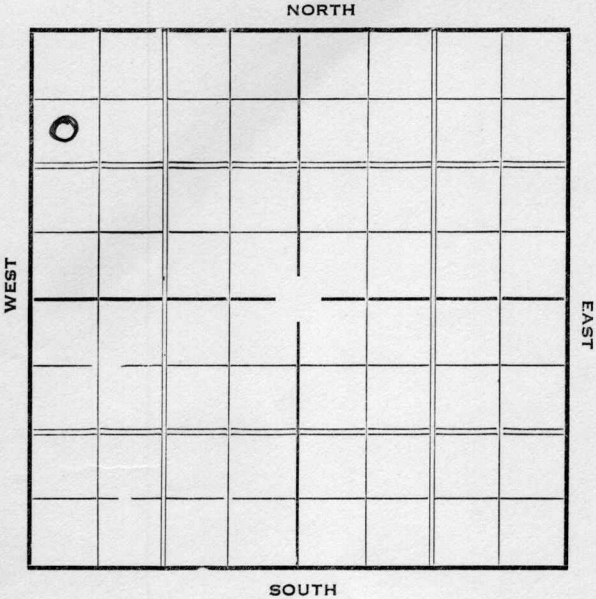

1937

6/23

6" @ 3261'.

Sil. 3259'.

T.D. 3270'.

Pot. 2376 bbls. Nat.

COMPLETED .

*Barton***KANSAS**Map No. _____ Sec. 24 Twp. 20 R. 11 WWell No. 6- H. PeterLario etal Company

Contractor _____

FIRST REPORT990 Ft. from N. Line

_____ Ft. from S. Line

_____ Ft. from E. Line

330 Ft. from W. Line**SECTION PLAT**

0			

Location _____

Rig up _____

Drilling and Remarks:

*B, R,***RECORD**

Cased _____ in., _____ ft.

Sand _____

Gas _____

Oil _____

Total Depth _____

PRODUCTION

1st 24 hrs. Nat. _____

1st 24 hrs. after shot _____

Gas _____ Cu. Ft.

Dry Hole _____

Abandoned _____

Date

APR 28 1887

19

H. D. Hatfield Scout

Barton KANSASMap No. *46* Sec. *24* Twp. *20* R. *11 W*Well No. *6-Herman Peter**Lario et al* Company

Contractor

COMPLETED

SECTION PLAT

<i>0</i>			

990 Ft. from N. Line

_____ Ft. from S. Line

_____ Ft. from E. Line

330 Ft. from W. Line

Location _____

Rig up _____

Drilling and Remarks:

*Rot - 2376**net*

RECORD

Cased *6* in., *3261* ft.~~Sand~~ *511 3259*

Gas _____

Oil _____

Total Depth *3270*

PRODUCTION

1st 24 hrs. Nat. _____

1st 24 hrs. after shot _____

Gas _____ Cu. Ft.

Dry Hole _____

Abandoned _____

Date

JUN 23 1937

19

H. D. Hatfield Scout