


Section.....25.....Township.....20.....Range.....11-W


Well Number.....1 Rose Bryant.....

Company.....I.T.I.O.....

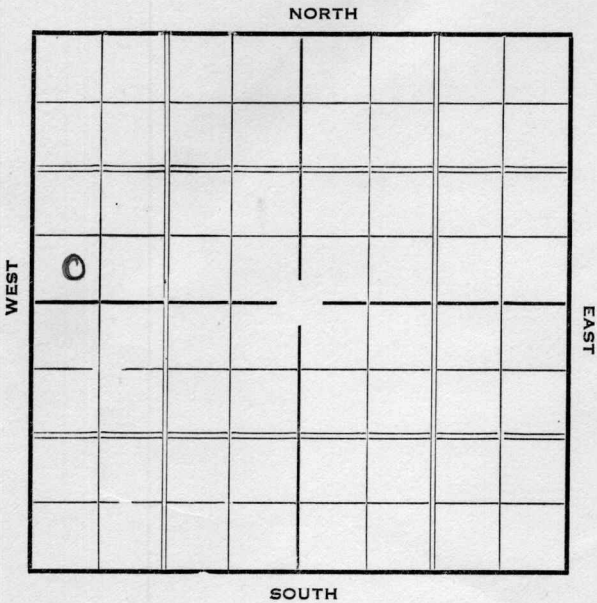

Sec. 25 Twp. 20 R. 11-WWell No. #1 Rose Bryant FarmITIO

Company

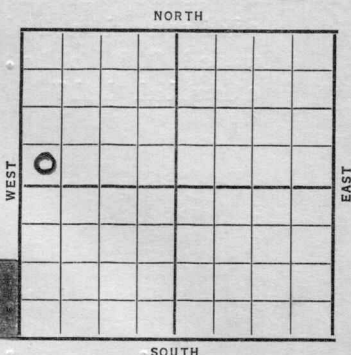 Ft. from N. Line330 Ft. from S. Line Ft. from E. Line440 Ft. from W. Line*Special*

Date	Elev. 1759	REPORT
1937		
4/21	Cellar	
4/30	"	
5/7	Surface hole.	
5/11	Dlg. 2200	(Tel)
5/15	Dlg. 2927	(Tel)
5/18	Top Siliceous 3277	7" 3277
	TD 3279	Not cored Cuttings showed
	oil	Had free oil in pits (Tel)
	Running 16 feet higher on top Siliceous	
	than ITIO #1 Schrepel-west offset.	
5/20	WOC (Tel)	ACIDIZED 2500 Gallons
5/22	Bailing mud	(Tel)
5/24	Drilled to 3296--500 feet oil in hole	
	Swabbed down At 3297 had 2000 feet	
	oil in hole At 3306 the total depth	
	had hole full oil Slopped over when	
	pulling bailer Running tubing (Tel)	
5/28	Pumped 726 bbls. in 12 hours	Down
	25 minutes This is after acidizing	
	Think use this gauge as potential (Tel)	

(OVER)

5/29--Top Siliceous 3277 T.D. 3306
Acidized with 2500 gallons acid
Pumped $708\frac{1}{2}$ bbls. in 12 hours (Corrected)
Potential 1417 bbls. (Tel)

6/2 7" @ 3277'.
Sil. 3277'.
T.D. 3306'.
2500 acid.
Potential 1417 bbls.
($708\frac{1}{2}$ bbls. 6 hrs)

COMPLETED

KANSAS *Barton*Map No. _____ Sec. *25* Twp. *20* R. *11W.*Well No. *1 Rose Bryant**J. T. J. O.*

Company

Contractor

Special

SECTION PLAT

_____ Ft. from N. Line

380 Ft. from S. Line

_____ Ft. from E. Line

440 Ft. from W. Line

FIRST REPORT

Location _____

Rig up _____

Drilling and Remarks:

De Har

RECORD

Cased _____ in., _____ ft.

Sand _____

Gas _____

Oil _____

Total Depth _____

PRODUCTION

1st 24 hrs. Nat. _____

1st 24 hrs. after shot _____

Gas _____ Cu. Ft.

Dry Hole _____

Abandoned _____

Date

APR 21 1937 19

S. J. LEWIS Scout

Map No. _____ Sec. 25 Twp. 20 R. 11 WWell No. 1 - Rose BryantL. T. L. O. Company

Contractor

COMPLETED

_____ Ft. from N. Line

330 Ft. from S. Line

_____ Ft. from E. Line

440 Ft. from W. Line

SECTION PLAT

0			

Location _____

Rig up _____

Drilling and Remarks:

2500 AcidPat - 1417(708 1/2 / 6 hrs)

RECORD

Cased 7 in., 3277 ft.Sand sil. 3277

Gas _____

Oil _____

Total Depth 3306

PRODUCTION

1st 24 hrs. Nat. _____

1st 24 hrs. after shot _____

Gas _____ Cu. Ft.

Dry Hole _____

Abandoned _____

Date

JUN 2 1937

19

H. D. Hatfield

Scout