


Company.....I.T.I.O.....

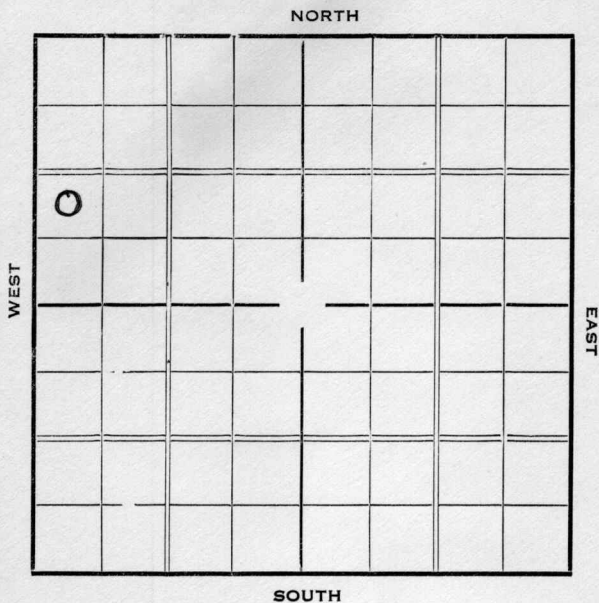

Barton KANSAS

Map No. _____ Sec. 25 Twp. 20 R. 11 WWell No. 2-BryantL. T. Co. Company

Contractor

FIRST REPORT

SECTION PLAT

0			

_____ Ft. from N. Line

990 Ft. from S. Line

_____ Ft. from E. Line

330 Ft. from W. LineLocation ✓

Rig up _____

Drilling and Remarks:

RECORD

Cased _____ in., _____ ft.

Sand _____

Gas _____

Oil _____

Total Depth _____

PRODUCTION

1st 24 hrs. Nat. _____

1st 24 hrs. after shot _____

Gas _____ Cu. Ft.

Dry Hole _____

Abandoned _____

Date

JUN 30 1937

19

H. D. Hatfield

Scout

Barton KANSASMap No. _____ Sec. *25* Twp. *20* R. *11 W*Well No. *2 - Bryant**S. T. I. O.* Company

Contractor

COMPLETED

SECTION PLAT

0			

_____ Ft. from N. Line

990 Ft. from S. Line

_____ Ft. from E. Line

330 Ft. from W. Line

Location _____

Rig up _____

Drilling and Remarks:

*Rot - 1733**nat*

RECORD

Cased *7* in., *3270* ft.Sand *511 3268*

Gas _____

Oil _____

Total Depth *3295*

PRODUCTION

1st 24 hrs. Nat. _____

1st 24 hrs. after shot _____

Gas _____ Cu. Ft.

Dry Hole _____

Abandoned _____

Date

AUG 4 - 1937 19 *H. D. Hatfield* Scout