


Barton

KANSAS

Section 25 Township 20 Range 11-W
Well No. #9 Rose Bryant
Company I.T.I.O.

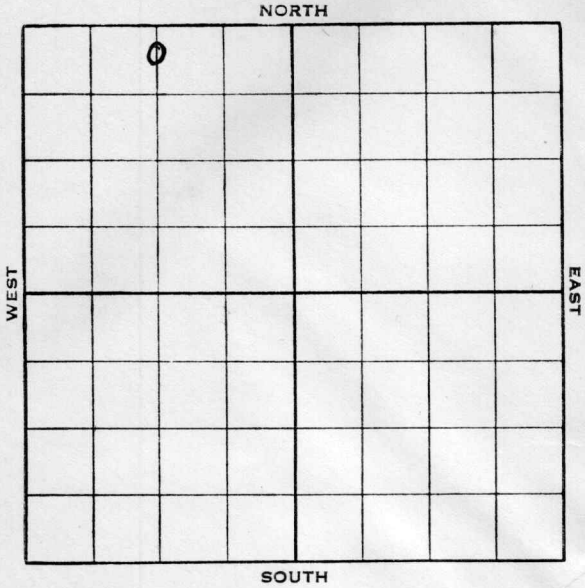

KANSAS


Barton

Sec. 25 Twp. 20 R. 11-WWell No. #9 Rose Bryant FarmI T I O

Company

330 Ft. from N. Line Ft. from S. Line Ft. from E. Line1320 Ft. from W. Line

Elev. 1754

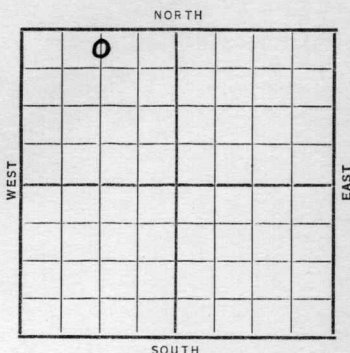

Date

REPORT

1938

7/6 S. H.

7/15 10" - 182'. Dlg. 2607'.

7/22 Arb. 3254-57'. S. O.

7" - 3254'. RUST.

7/29 Arb. & 7" - 3248' (Corrected)

T. D. 3259'. Swab 311 oil 6

hrs. 2500' off bottom.

8/5 T.D. 3263'. Pump 164 oil in
5 hours.

8/10 7" - 3248'.

Arb. 3248'.

T. D. 3263'.

Pump 425 bbls. 4 hrs. & 405 bbls
4 hours.

Potential 2429 bbls.

COMPLETED

Barton KANSAS

Map No. 46 Sec. 25 Twp. 20 R. 11WWell No. 9 Rose Bryant

I T I O

Company

Contractor

FIRST REPORT
C N L NW

SECTION PLAT

330 Ft. from N. Line Ft. from S. Line Ft. from E. Line1320 Ft. from W. Line

0		

Location

RECORD

Cased in., ft.Sand Gas Oil Total Depth

PRODUCTION

1st 24 hrs. Nat. 1st 24 hrs. after shot Gas Cu. Ft.Dry Hole Abandoned

Drilling and Remarks:

SH

Date

JUL 6 - 1938 19

H. D. Hatfield Scout

Barton

KANSAS

Map No. 46 Sec. 25 Twp. 20 R. 11WWell No. 9 Rose Bryant

I T I O

Company

Contractor

COMPLETED

C N L NW

330 Ft. from N. Line

Ft. from S. Line

Ft. from E. Line

1320 Ft. from W. Line

SECTION PLAT

0		

Location

Rig up

Drilling and Remarks:

P-425/4 + 405/4

Pot 2429

RECORD

Cased 7 in., 3248 ft.Sand Arb 3248

Gas

Oil

Total Depth 3263

PRODUCTION

1st 24 hrs. Nat.

1st 24 hrs. after shot

Gas Cu. Ft.

Dry Hole

Abandoned

Date

AUG 10 1938

19

H. D. Hatfield Scout