

KANSAS

Map No. _____ Sec. 33 Twp. 18 R. 9W


Well No. 6-Ploog Farm _____

Shell Pet et al Company

NORTH

WEST

EAST

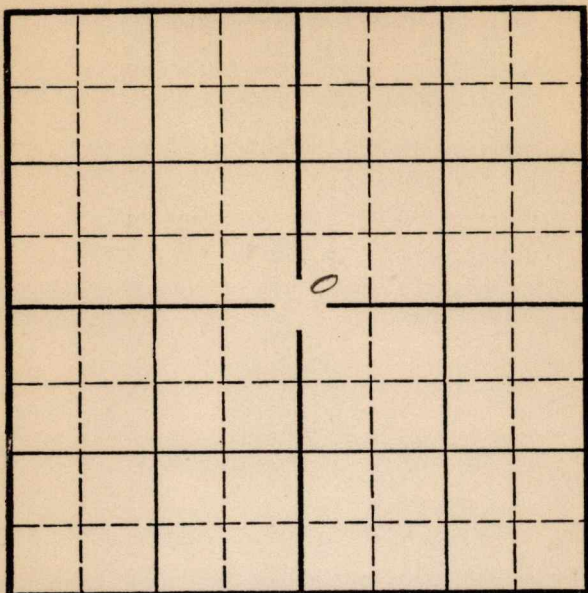

SOUTH

Location _____
Drilling Remarks _____

Rig Up _____
Drilling Remarks _____

RECORD

Cased _____ in. _____ ft.
Sand _____
Gas _____
Oil _____
Total Depth _____

PRODUCTION

1st 24 hrs. Nat. _____
1st 24 hrs. after shot _____
Gas _____ cu. ft. _____
Dry Hole _____
Abandoned _____


Map No. KANSAS Sec. 33 Twp. 18 R. 9W
Well No. 6- Ploog Farm
Shell Pet Petal Company

Ft. from N. Line

440 Ft. from S. Line

Ft. from E. Line

400 Ft. from W. Line

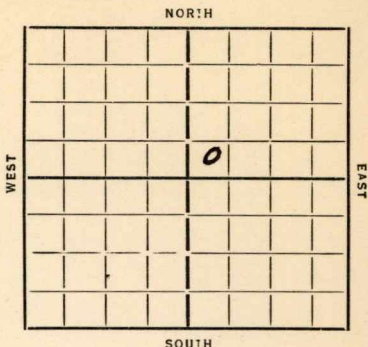

Date 1935 REPORT

7/24 Rig up
8/8 ddy 2604
8/15 KC 2886
220 2967-88
ddy 3170
8/22 Cong 3165 7" 3165
Bailing
8/29 7" 3170 Sil 3233-34
140 run liner
9/6 3257 T7
9/12 Sil 3233
T7 3257
1000 acid
580 Hblw.

COMPLETED

Map No. 45 Sec. 33 Twp. 18 R. 9 W

Well No. 6 Plog

Shelton Petroleum Company

Contractor

FIRST REPORTS

SECTION PLAT

.....Ft. from N. Line

440 Ft. from S. Line

.....Ft. from E. Line

400 Ft. from W. Line

		0	

Location.....

Rig up ☒

Drilling and Remarks:

RECORD

Cased.....in., ...ft.

Sand.....

Gas.....

Oil.....

Total Depth.....

PRODUCTION

1st 24 hrs. Nat.....

1st 24 hrs. after shot.....

Gas.....Cu. Ft.

Dry Hole.....

Abandoned.....

Date

7/24/35 192.....

ORVAL MANNSCHECK

Scout

KANSAS

Map No. 45 Sec. 33 Twp. 18 R. 9WWell No. 6-PloughShell petroleum Company

Contractor

COMPLETED

SECTION PLAT

		0	

Ft. from N. Line

440 Ft. from S. Line

Ft. from E. Line

440 Ft. from W. Line

Location

Rig up

Drilling and Remarks:

1000 rods580 bbls

RECORD

Cased in. ft.Sand sil 3233

Gas

Oil

Total Depth 3257

PRODUCTION

1st 24 hrs. Nat.

1st 24 hrs. after shot

Gas Cu. Ft.

Dry Hole

Abandoned

Date

9-12-35 192

ORVAL MANNSCHRECK Scout