


RICE

DX 78-1

KANSAS

Section 34 Township 18S Range 9W
Well No. #1 Kilburn
Company Carl Lebsack

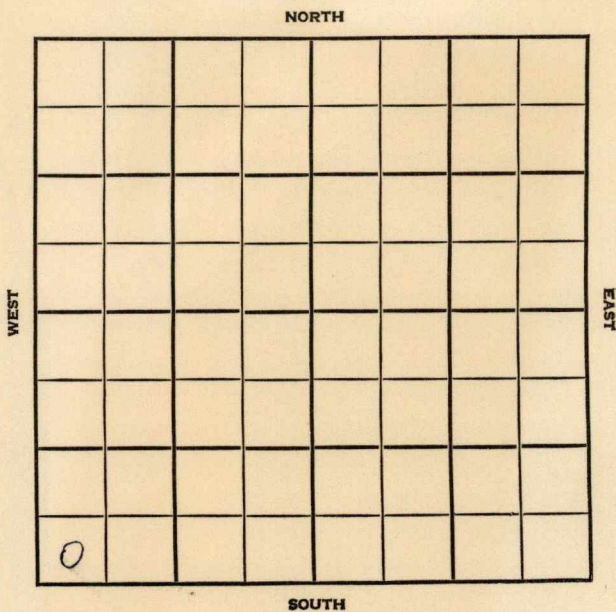

Rice

KANSAS

SEC.

TWP.

R.

34

18S

9W

WELL NO.

1 Kilburn

FARM

COMPANY

Carl Lebsack

CONTRACTOR

Isern

(WILDCAT)


____ FT. FROM N. LINE

____ FT. FROM S. LINE

____ FT. FROM E. LINE

____ FT. FROM W. LINE

SW SW SW

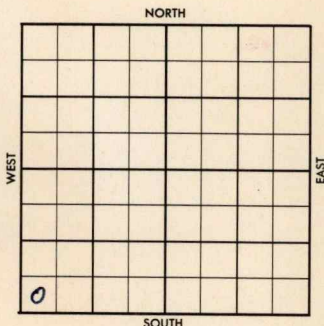

1956

ELEVATION

1723'

REPORT

6-20

MIRT

7-18

Comm. 6-18-56

8 5/8" @ 226 w/150

DST 3210-35 op 1 hr, rec. 8' mud, BHP 0#

DST 3210-50 op 1 hr, rec. 1345' oil,
BHP 975#DST 3288-91 op 1 hr, rec. 950' WM,
BHP 1050

5 1/2" @ 3290

CO 16/3234-38

FU 2000' oil in 2 1/2 hrs.

S/ 20 BOPH, 4 hrs.

P/ 50 BOPD, no/wtr.

Anh. 453'; H. 2740'; BL. 2871'; L. 2896'

C. 3220'; S. 3242'; A. 3286';

TD 3291'

COMPLETED

County Rice Elev. 1723 Co. 1
 Sec. 34 Twp. 18S Rge. 9W
 Company Carl Lebsack
 Farm Name Kilburn No. 1

TOPS	DEPTH	LOG	DATUM	Loc. in Sec.
Anb.	453			SW SW SW
Tp.				
H.	2740			
Tr.				
Dg.				
BL.	2871			
L.	2896 2898?			Geol.
K.C.				
B.K.C.				Contr.
Ce.				Isern
C.	3220			
M.				
M.				Pool
K.				W.C. Keller
Mz.				
Ma.				
V.				COMPLETE
S.	3242			JUL 1 8 1956
S.				
A.	3286			
R.				
PE.				
G.				
TD.	3291			

Date Comm.

MIRT JUN 27 '56 6-18-56 8⁵/₈ 226

1150 1P 3175 JUL 3 '56 Pipeset JUL 11 '56

DST 3210-35 1hr rec. 8' md BHP

0 DST 3210-50 1hr. rec. 1345' oil

BHP 975 DST 3288-91 1hr rec.


950' WM BHP 1050 5¹/₂ @ 3290CO 16/3234-38 FU 2000' oil in 2¹/₂

hr & 20 Boph 4 hrs # POP JUL 18 '56

P. 50 Bopd no/wtr

County Rice Elev. _____
 Sec. 34 Twp. 18S Rge. 9W
 Company Carl Lebsack
 Farm Name Kilburn No. 1

TOPS	DEPTH	LOG	DATUM	Loc. in Sec.
Anh.				SW SW SW
Tr.				
H.				
Tr.				
Dg.				
Bl.				
L.				
K.C.				Geol. _____
B.K.C.				Contr. _____
Ce.				Isern
C.				
M.				Pool
K.				W.C.
Mz.				
Me.				
V.				
S.				
S.				
A.				
R.				
PE.				
G.				
T.D.				

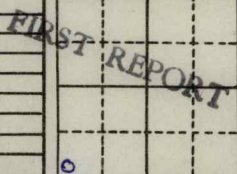

Date Comm. MIRT JUN 20 '56

JUN 25 1956

[Handwritten signature]

[Large handwritten '12' with a checkmark]