

KANSAS

Barton


FORM 51 5M 1-42 PETROL

Section 25 Township 20 Range 11-W

Well No. 9 Roetzel

Company Magnolia

NORTH Silica Pool

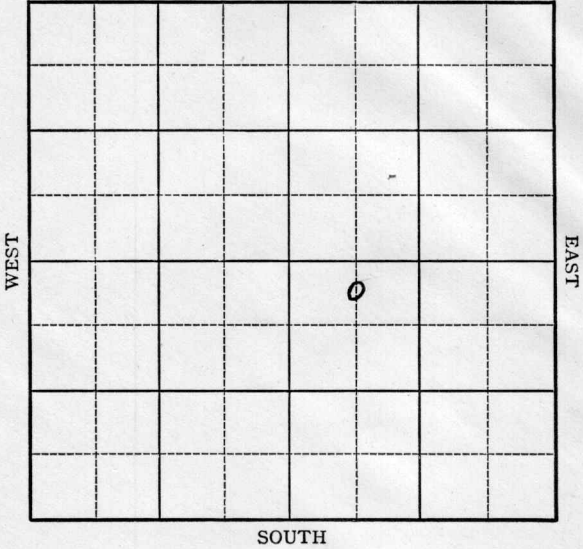

Sec 25 Twp. 20 R. 11-W

Well No. #9 Roetzel Farm

Magnolia Company

(Silica)


330 Ft. from N. Line

         Ft. from S. Line

660 Ft. from E. Line

660 Ft. from W. Line

Elev. 1757

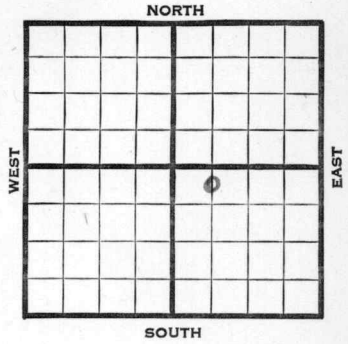

1942		REPORT
2/18	Location	
2/26	"	
3/5	"	
3/12	"	
3/19	10" - 226'	WOC.
3/26	Drlg.	3130'
4/2	Simp.	3287' Arb. 3301-08' T.D.
	5" - 3304'	RUST.
4/8	Arb.	3301'
	5" - 3304'	
	T.D.	3314'
	Potential	125 bbls., pump.
	43.	Gravity
	<b>COMPLETED</b>	

Map No. 46 Sec. 25 Twp. 20 R. 11W

Well No. 9 Roetzel

Magnolia Company

**FIRST REPORT** Contractor

C NL NW SE

330 Ft. from N. Line

\_\_\_\_\_ Ft. from S. Line

660 Ft. from E. Line

660 Ft. from W. Line

SECTION PLAT

		o	

SILICA POOL

Location XXX

Rig up \_\_\_\_\_

Drilling and Remarks:

RECORD

Cased \_\_\_\_\_ in., \_\_\_\_\_ ft.

Sand \_\_\_\_\_

Gas \_\_\_\_\_

Oil \_\_\_\_\_

Total Depth \_\_\_\_\_

PRODUCTION

1st 24 hrs. Nat. \_\_\_\_\_

1st 24 hrs. after shot \_\_\_\_\_

Gas \_\_\_\_\_ Cu. Ft.

Dry Hole \_\_\_\_\_

Abandoned \_\_\_\_\_

Date

FEB 18 1942 19

S. J. LEWIS Scout

Please check spot & feet measurements.

Company

Contractor

Paul.

SECTION PLAT


RECORD

Casey  
Sand  
Gas  
Oil

Drilling and Remarks:

Misc. Small Maps

Cards

Tracing

France Map

Scarborough

Moody Map

Geological Dept.

Moody Plat Book

Date

Barton

KANSAS

Map No. 46 Sec. 25 Twp. 20 R. 11W

Well No. 9 Roetzel

Magnolia

Company

(COMPLETED)

Contractor

C NL NW SE

SECTION PLAT

330 Ft. from N. Line

		o	

\_\_\_\_\_ Ft. from S. Line

\_\_\_\_\_ Ft. from E. Line

660 Ft. from W. Line

SILICA POOL

Location \_\_\_\_\_

RECORD

Rig up \_\_\_\_\_

Drilling and Remarks:

Cased \_\_\_\_\_ in., \_\_\_\_\_ ft.

Sand \_\_\_\_\_

Gas \_\_\_\_\_

Oil \_\_\_\_\_

Total Depth 3314

*Car 3301*

*5" C 3304*

*Pump 125 R & L*

PRODUCTION

1st 24 hrs. Nat. \_\_\_\_\_

1st 24 hrs. after shot \_\_\_\_\_

Gas \_\_\_\_\_ Cu. Ft.

Dry Hole \_\_\_\_\_

Abandoned \_\_\_\_\_

*43<sup>o</sup> Gr*

Date

APR 8 1942 19

S. J. LEWIS Scout