


Map No. **KANSAS** Sec. 4 Twp. 18 R. 10^W

Well No. 1 *Thurpe*
Allison & Fitzwilliams ^{Farm} *stat* Company

NORTH

WEST

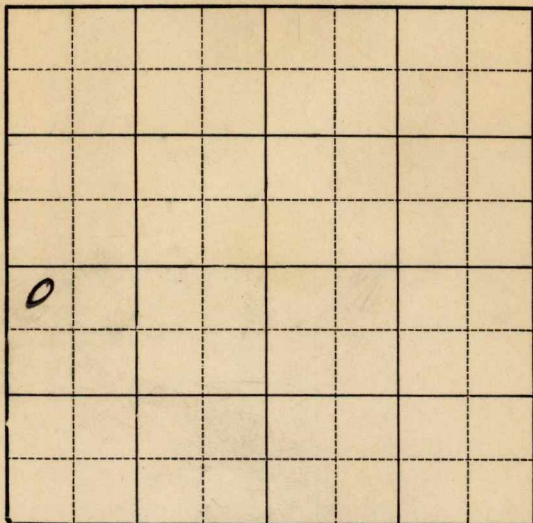

EAST

SOUTH

Location _____

Drilling Remarks _____

Rig Up _____

Drilling Remarks _____

RECORD

Cased _____ in. _____ ft.

Sand _____

Gas _____

Oil _____

Total Depth _____

PRODUCTION

1st 24 hrs. Nat. _____

1st 24 hrs. after shot _____

Gas _____ cu. ft.

Dry Hole _____

Abandoned _____

Rice

Map No. KANSAS Sec. 4 Twp. 18 R. 10^W


Well No. 1 Stumps Farm
Allison & Fitzwilliams et al Company

330 Ft. from N. Line

 Ft. from S. Line

 Ft. from E. Line

330 Ft. from W. Line

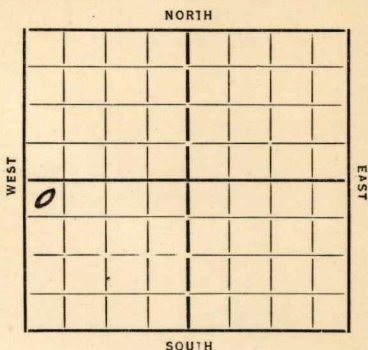

Date	REPORT
12/19	Location
12/27	—
1/3/35	Rig
1/10	—
1/17	Rgn
1/24	—
1/31	Spud
2/7	15" 484
2/14	12" 1460 C.O.
2/21	12" 1775
2/28	" 2075 10" 1880
3/7	" 2603
3/14	8" 2865 WOC
3/21	12" 3100
3/28	" 3158 6" 3150
4/4	Silicious 3229 S.O. 3241
	Inc 3247-61 Est 40 Bbls per day
	Acidizing
4/11	Pumped Water Lowering 6"
4/18	6" 3235 WOC
4/26	Pump 2 Bbls oil per hr
	Acidize (OVER)

5/2 3267 T7
2700' oil
P 218 Bbls 10 hrs.

5/8 Siliceous 3229
T7 3267
1000 acid
546 Bbls 21 hrs.

COMPLETED

Map No. 55 Sec. 4 Twp. 18 R. 10WWell No. 1 - StumpsAllison & Fitzwilliams Company

Contractor

COMPLETED

SECTION PLAT

0			

330 Ft. from N. Line

Ft. from S. Line

Ft. from E. Line

330 Ft. from W. Line

Location

Rig up

Drilling and Remarks:

1000 and546 lbs.21 lbs

RECORD

Cased _____ in., _____ ft.

Sand Silurian 3229

Gas _____

Oil _____

Total Depth 3267

PRODUCTION

1st 24 hrs. Nat. _____

1st 24 hrs. after shot _____

Gas _____ Cu. Ft.

Dry Hole _____

Abandoned _____

Date

5-8-35

192

ORVAL MANNSCHRECK

Scout

Map No. 55 Sec. 4 Twp. 18 R. 10^WWell No. 1 - StumpsAllison + Fitzwilliams et al Company

Contractor

FIRST REPORTS

SECTION PLAT

330 Ft. from N. Line

Ft. from S. Line

Ft. from E. Line

330 Ft. from W. Line

0			

Location ✓

Rig up

Drilling and Remarks:

RECORD

Cased.....in.,ft.

Sand.....

Gas.....

Oil.....

Total Depth.....

PRODUCTION

1st 24 hrs. Nat.....

1st 24 hrs. after shot.....

Gas.....Cu. Ft.

Dry Hole.....

Abandoned.....

Date

12-19-34 192

ORVAL MANNSCHRECK

Scout