


Barton

Section 25 Township 20 Range 11-W

Well No. 5 Anna Roetzel

Company Magnolia

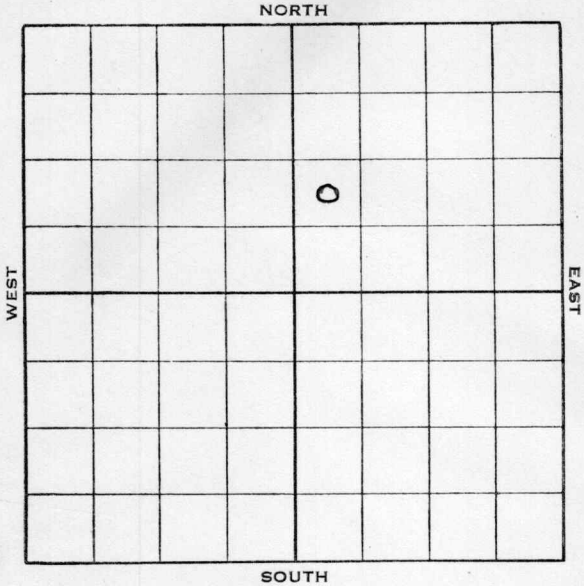

Sec. 25 Twp. 20 R. 11-W

Well No. #5 Anna Roetzel Farm
Magnolia Company


 Ft. from N. Line

990 Ft. from S. Line

 Ft. from E. Line

330 Ft. from W. Line

Elev. 1752

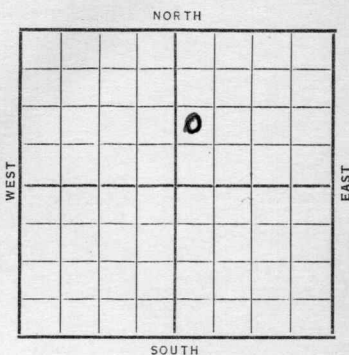

Date	REPORT
1938	
2/16	Cellar.
2/26	"
3/4	13" @ 187'. Drlg. 2460'.
3/11	Arb. 3265'. T.D. 3268', 7" @ 3266'. S.O. RUST.
3/18	" " " " "
3/23	7" @ 3266'.
	Arb. 3265'.
	T.D. 3277'.
	2000 acid.
	Potential 1668 bbls.
	COMPLETED

Map No. _____ Sec. 25 Twp. 20 R. 11W

Well No. 5 Anna Roetzel

Magnolia Company

Contractor

FIRST REPORT

SECTION PLAT

NW SW NE

_____ Ft. from N. Line

990 Ft. from S. Line

_____ Ft. from E. Line

330 Ft. from W. Line

		0	

Location _____

Rig up _____

Drilling and Remarks:

Cellar

RECORD

Cased _____ in., _____ ft.

Sand _____

Gas _____

Oil _____

Total Depth _____

PRODUCTION

1st 24 hrs. Nat. _____

1st 24 hrs. after shot _____

Gas _____ Cu. Ft.

Dry Hole _____

Abandoned _____

Date

FEB 16 1938 19

H. D. Hatfield

Scout

Barton

Map No. 46 Sec. 25 Twp. 20 R. 11W

Well No. 5 Anna Roetzel

Magnolia

Company

Contractor

COMPLETED

NW SW NE

_____ Ft. from N. Line

990 Ft. from S. Line

_____ Ft. from E. Line

330 Ft. from W. Line

SECTION PLAT

		0	

Location _____

Rig up _____

Drilling and Remarks:

2000 acid

LOT 1668

RECORD

Cased 7 in., 3266 ft.

Sand 4-6 3265

Gas _____

Oil _____

Total Depth 3277

PRODUCTION

1st 24 hrs. Nat. _____

1st 24 hrs. after shot _____

Gas _____ Cu. Ft.

Dry Hole _____

Abandoned _____

Date

MAR 23 1938

19

H. D. Hatfield

Scout