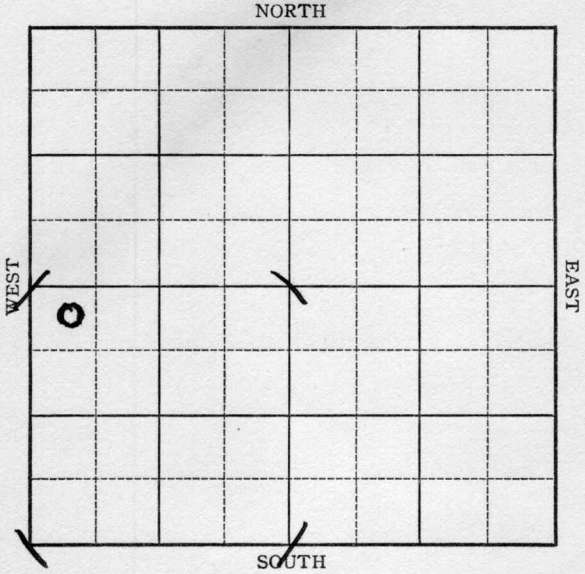
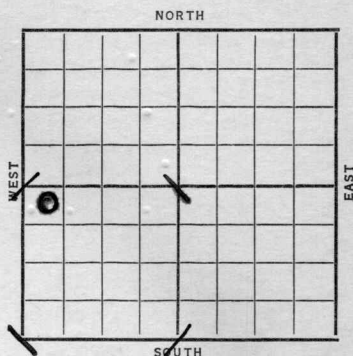


Barton

Section 25 Township 20 Range 11-WWell No. 1 - Schrepel "B"Company I.T.I.O.

Sec. 25 Twp. 20 R. 11-WWell No. #1 Schrepel "B" FarmITIO

Company

330 Ft. from N. Line Ft. from S. Line Ft. from E. Line440 Ft. from W. Line*Special*

Date	Elev. 1762	REPORT
1937		
6/2	Cellar	
6/11	B. R.	
6/19	12" @ 206'. WOC.	
6/25	Dr1g. 1913'.	
7/2	Sil. 3295'. Rng. pipe.	
7/9	7" @ 3295'. T.D. 3296'.	
	C.O.	
7/16	T.D. 3306½'. 2600' oil.	
7/23	150 acid. Testing.	
7/30	T.D. 3306' S.D.O.	
8/6	" " " "	
8/13	" " " "	
8/20	" " " "	
8/28	" " " "	
9/3	" " " "	
9/10	" " " "	
9/17	" " " "	
9/24	" " " "	
10/2	Shot off pipe @ 2200'.	
	Set whipstock @ 2250'.	
	Dr1g. 2275'.	

OVER

1937

10/8 Drlg. 2500'.

10/15 Drlg. 2915'.

10/22 Sil. & 7" @ 3298'. T.D. 3300'.
RUST. S.O.

10/29 " "

11/3 7" @ 3298'.

Sil. 3298'.

T.D. 3325'.

2000 acid.

Potential 1267 bbls.

COMPLETED

Barton KANSASMap No. *46* Sec. *25* Twp. *20* R. *11 W*Well No. *1-Schrepel "B"**Itiso,* Company

Contractor

FIRST REPORT

SECTION PLAT


330 Ft. from N. Line

Ft. from S. Line

Ft. from E. Line

440 Ft. from W. Line

Special

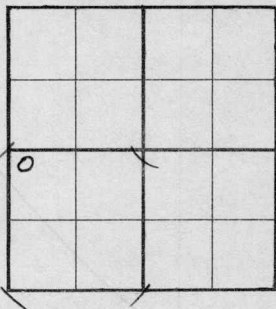

Location _____

Rig up _____

Drilling and Remarks:

Cellar

RECORD

Cased _____ in., _____ ft.

Sand _____

Gas _____

Oil _____

Total Depth _____

PRODUCTION

1st 24 hrs. Nat. _____

1st 24 hrs. after shot _____

Gas _____ Cu. Ft.

Dry Hole _____

Abandoned _____

Date

JUN 2 1937 19

H. D. Hatfield

Scout

Barton

KANSAS

Map No. _____ Sec. 25 Twp. 20 R 11 WWell No. 1 Schrepel "B"

ITIO

Company _____

Contractor _____

COMPLETED

NW SW

330 Ft. from N. Line

_____ Ft. from S. Line

_____ Ft. from E. Line

440 Ft. from W. Line

SECTION PLAT

0			

Location _____

Rig up _____

Drilling and Remarks:

2000 Acid.POT-1267

RECORD

Cased 7 in. 3298 ft.Sand sil 3298

Gas _____

Oil _____

Total Depth 3325

PRODUCTION

1st 24 hrs. Nat. _____

1st 24 hrs. after shot _____

Gas _____ Cu. Ft.

Dry Hole _____

Abandoned _____

Date

NOV 3 1937H. D. Hatfield Scout