





Sec. 25 Twp. 20 R. 11-W

Well No. #3 Schrepel "B" Farm

Cities Service Company

Silica Pool


\_\_\_\_\_ Ft. from N. Line

990' Ft. from S. Line

\_\_\_\_\_ Ft. from E. Line

330' Ft. from W. Line

NW SW SW

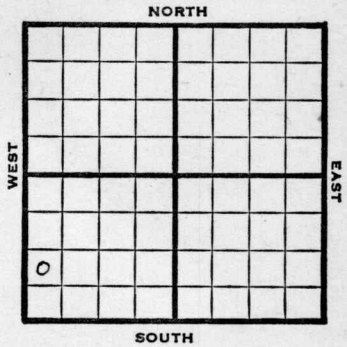

1947	Elev. 1767' REPORT
11/12	Location
11/16	8" @ 212' WOC
11/25	Drlg. 3044'
12/3	Lans. 3064' Arbuckle 3337' Total 3369'
<b>ABANDONED</b>	

Map No. \_\_\_\_\_ Sec. 25 Twp. 20 R. 11W

Well No. 3 Schrepel "B"

Cities Service Company

FIRST REPORT Contractor

NW SW SW


SECTION PLAT

\_\_\_\_\_ Ft. from N. Line

990 Ft. from S. Line

\_\_\_\_\_ Ft. from E. Line

330 Ft. from W. Line

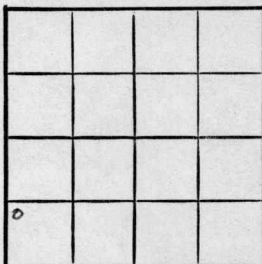

Barton County

Location X

Rig up \_\_\_\_\_

Drilling and Remarks:

RECORD

Cased \_\_\_\_\_ in., \_\_\_\_\_ ft.

Sand \_\_\_\_\_

Gas \_\_\_\_\_

Oil \_\_\_\_\_

Total Depth \_\_\_\_\_

PRODUCTION

1st 24 hrs. Nat. \_\_\_\_\_

1st 24 hrs. after shot \_\_\_\_\_

Gas \_\_\_\_\_ Cu. Ft.

Dry Hole \_\_\_\_\_

Abandoned \_\_\_\_\_

Date

NOV 12 1947

19

S. J. LEWIS

Scout

