


Map No. **KANSAS** Sec. 4 Twp. 18 R. Rice 10<sup>W</sup>

Well No. 1-A Moran Farm  
Stick, P & L Company

NORTH

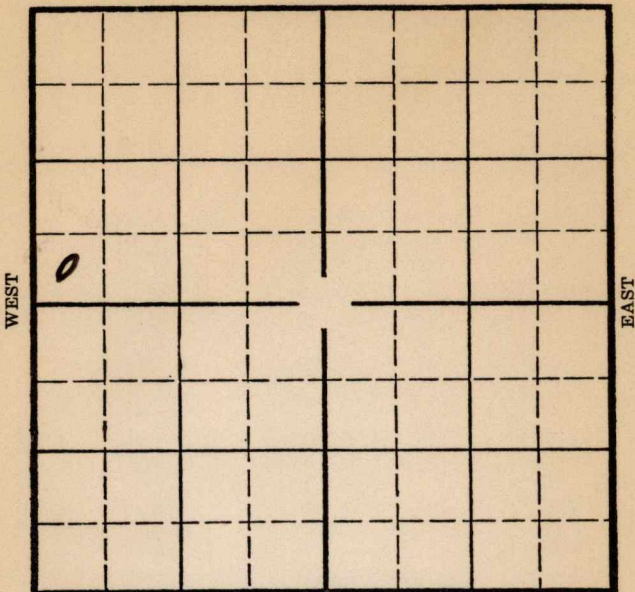

SOUTH

Location \_\_\_\_\_

Drilling Remarks \_\_\_\_\_  
\_\_\_\_\_  
\_\_\_\_\_  
Rig Up \_\_\_\_\_

Drilling Remarks \_\_\_\_\_  
\_\_\_\_\_  
\_\_\_\_\_  
**RECORD**

Cased \_\_\_\_\_ in. \_\_\_\_\_ ft.

Sand \_\_\_\_\_

Gas \_\_\_\_\_

Oil \_\_\_\_\_

Total Depth \_\_\_\_\_

**PRODUCTION**

1st 24 hrs. Nat. \_\_\_\_\_

1st 24 hrs. after shot \_\_\_\_\_

Gas \_\_\_\_\_ cu. ft. \_\_\_\_\_

Dry Hole \_\_\_\_\_


Abandoned \_\_\_\_\_

Rice

Map No. KANSAS Sec. 4 Twp. 18 R. 10<sup>W</sup>

Well No. 1-A Moran Farm  
Alch P & L Company

Ft. from N. Line  
330 Ft. from S. Line  
Ft. from E. Line  
330 Ft. from W. Line

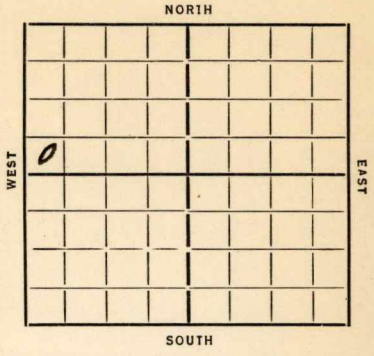

**Elev. 1781**

Date	REPORT
5/28	Location
6/6	—
6/13	Cellar
6/20	Rig
6/28	7/3 —
7/11	Rough
7/18	Spud
8/8	dy 1943
8/15	" 2730
8/22	dy 2910-20 8" 2924
8/29	dy 2930 8" 2935 20 30 25 20 30 70 Oil 3105-10
9/6	dy 3132 Oil 3224-50 gravel 3218 500' Oil 3238 2000' " 3248 T 3250
9/12	Oil 3224 T 3250 993 bbl.

**COMPLETED**

KANSAS

Map No. 555 Sec. 4 Twp. 18 R. 10W

Well No. 1A - Moran

Slick Pt L Company

Contractor

FIRST REPORTS

SECTION PLAT

..... Ft. from N. Line

330 Ft. from S. Line

..... Ft. from E. Line

330 Ft. from W. Line

0			

Location

Rig up .....

Drilling and Remarks:

RECORD

Cased ..... in., ..... ft.

Sand .....

Gas .....

Oil .....

Total Depth .....

PRODUCTION

1st 24 hrs. Nat. ....

1st 24 hrs. after shot .....

Gas ..... Cu. Ft.

Dry Hole .....

Abandoned .....

Date

5-28-35

192

ORVAL MANNSCHRECK

Scout

KANSAS

Map No. 55 Sec. 4 Twp. 18 R. 10<sup>w</sup>

Well No. 1A-Moran

Slick, Perry & J Company

Contractor

SECTION PLAT

COMPLETED

..... Ft. from N. Line

330 Ft. from S. Line

..... Ft. from E. Line

330 Ft. from W. Line

0.			

Location.....

Rig up.....

Drilling and Remarks:

993 bbls

RECORD

Cased..... in., ..... ft.

Sand Sil 3224

Gas.....

Oil.....

Total Depth 3250

PRODUCTION

1st 24 hrs. Nat.....

1st 24 hrs. after shot.....

Gas..... Cu. Ft.

Dry Hole.....

Abandoned.....

Date

9-12-35 192.....

ORVAL MANNSCHRECK

Scout