


KANSAS

Rice County

Section 4 Township 18 Range 10W

Well No. #2 Clare

Company Transwestern et al

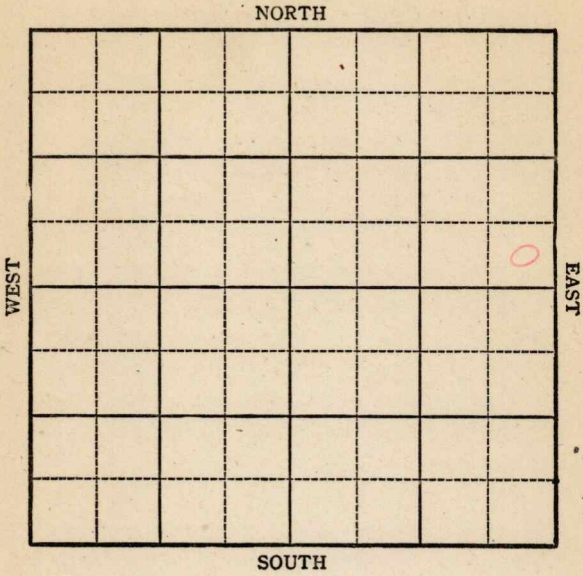

KANSAS

Rice County

Sec. 4 Twp. 18 R. 10W

Well No. #2 Clare Farm _____

Transwestern et al Company _____


Bloomer

_____ Ft. from N. Line

330 Ft. from S. Line

330 Ft. from E. Line

_____ Ft. from W. Line

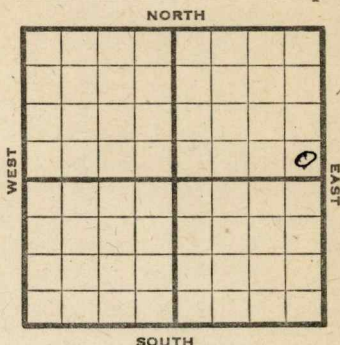

SE NE

1944

R E P O R T

10/18

Rotary

10/25

8" @ 253

Drlg. 2260

11/1

Lans 2938

Arb 3271

TD 3298

ABANDONED

Pool Name Bloomer

Map No. 55 **KANSAS** Sec. 4 Twp. 18 R. 10W

Well No. 2 Clare

Transwestern etal Company

FIRST REPORT Contractor

SE NE

SECTION PLAT

 Ft. from N. Line

330 Ft. from S. Line

330 Ft. from E. Line

 Ft. from W. Line

Rice County

Location

Rig up

Drilling and Remarks:

Rota ry

RECORD

Cased in., ft.

Sand

Gas

Oil

Total Depth

PRODUCTION

1st 24 hrs. Nat.

1st 24 hrs. after shot

Gas Cu. Ft.

Dry Hole

Abandoned

Date

OCT 1 8 1944 19

S. J. LEWIS Scout

Pool Name Bloomer

Map No. 55 Sec. 4 Twp. 18 R. 10W

Well No. 2 Clare

Transwestern et al Company

ABANDONED

Contractor

SE NE

SECTION PLAT

			o

 Ft. from N. Line

330 Ft. from S. Line

330 Ft. from E. Line

 Ft. from W. Line

Rice

Location

Rig up

Drilling and Remarks:

Liams 2938

Ar 83271

RECORD

Cased in., ft.

Sand

Gas

Oil

Total Depth 3298

PRODUCTION

1st 24 hrs. Nat.

1st 24 hrs. after shot

Gas Cu. Ft.

Dry Hole

Abandoned

Date

NOV 1 1944 19

S. J. LEWIS Scout