


Section 26 Township 20 Range 11-W

Well No. #4 Schrepel "A"

Company I. T. I. O.

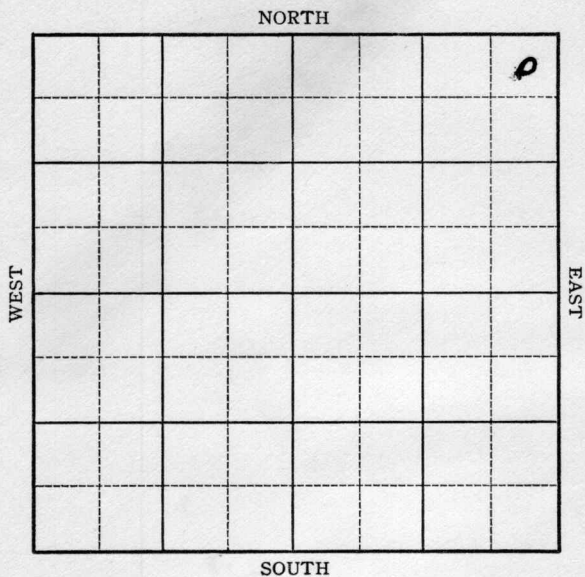

Sec. 26 Twp. 20 R. 11-W

Well No. #4 Schrepel "A" Farm

I.T.I.O. Company


330 Ft. from N. Line

_____ Ft. from S. Line

330 Ft. from E. Line

_____ Ft. from W. Line

Elev. 1757

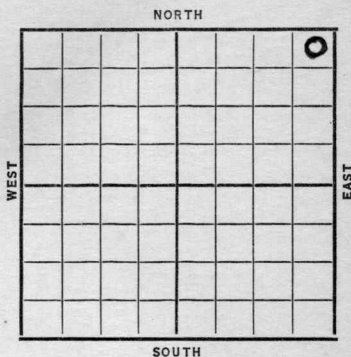

Date	REPORT
1937	
9/22	Location
10/2	R U R
10/8	10" @ 201'. Drlg. 1900'.
10/15	Sil. 3257'. 7" @ 3257'.
	T.D. 3259'. RUST.
10/22	T.D. 3273'. Flowed 349 B.O.
	9 hrs. C.O.
10/27	7" @ 3257'.
	Sil. 3257'.
	T.D. 3273'.
	Potential 2198 bbls.
	Pump & flow.
	COMPLETED

Barton KANSAS

Map No. _____ Sec. 26 Twp. 20 R. 1125

Well No. 4 Schapel "a"

L.T.I.O.

Company _____

Contractor _____

FIRST REPORT

SECTION PLAT

330 Ft. from N. Line

_____ Ft. from S. Line

330 Ft. from E. Line

_____ Ft. from W. Line

			0

Location ✓

Rig up _____

Drilling and Remarks:

RECORD

Cased _____ in., _____ ft.

Sand _____

Gas _____

Oil _____

Total Depth _____

PRODUCTION

1st 24 hrs. Nat. _____

1st 24 hrs. after shot _____

Gas _____ Cu. Ft.

Dry Hole _____

Abandoned _____

Date

SEP 22 1937

19

H. D. Hatfield

Scout

Barton

KANSAS

Map No. _____ Sec. 26 Twp. 20 R. 11W

Well No. 4 Schrepel "A"

ITIO

Company

Contractor

COMPLETED

NE/C

330 Ft. from N. Line

_____ Ft. from S. Line

330 Ft. from E. Line

_____ Ft. from W. Line

SECTION PLAT

			0

Location _____

Rig up _____

Drilling and Remarks:

POT-2198

Pump & Flow

RECORD

Cased 7 in., 3257 ft.

Sand 511 3257

Gas _____

Oil _____

Total Depth 3273

PRODUCTION

1st 24 hrs. Nat. _____

1st 24 hrs. after shot _____

Gas _____ Cu. Ft.

Dry Hole _____

Abandoned _____

Date

OCT 27 1937

19

H. D. Hatfield

Scout