


Map No. **KANSAS** Sec. 4 Twp. 18 R. 10W  
Well No. 7-Moran *Rice*  
Slick, Preps & Lockhart etc Farm Company

NORTH

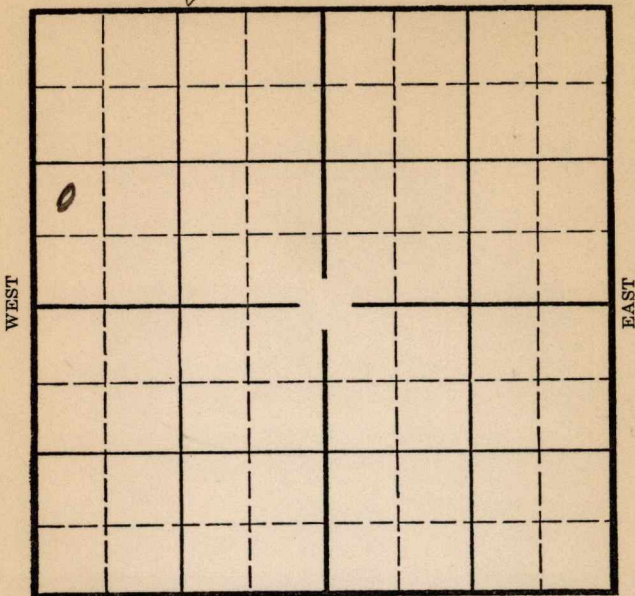

SOUTH

Location \_\_\_\_\_

Drilling Remarks \_\_\_\_\_  
\_\_\_\_\_  
\_\_\_\_\_  
Rig Up \_\_\_\_\_

Drilling Remarks \_\_\_\_\_  
\_\_\_\_\_  
\_\_\_\_\_  
**RECORD**

Cased \_\_\_\_\_ in. \_\_\_\_\_ ft.

Sand \_\_\_\_\_

Gas \_\_\_\_\_

Oil \_\_\_\_\_

Total Depth \_\_\_\_\_

**PRODUCTION**

1st 24 hrs. Nat. \_\_\_\_\_

1st 24 hrs. after shot \_\_\_\_\_

Gas \_\_\_\_\_ cu. ft. \_\_\_\_\_

Dry Hole \_\_\_\_\_

Abandoned \_\_\_\_\_

KANSAS

Map No. \_\_\_\_\_ Sec. 4 Twp. 18 R. 10<sup>w</sup>

Well No. 2-Moran \_\_\_\_\_ Farm

Slick, Pryor & Lockhart et al Company


\_\_\_\_\_ Ft. from N. Line

990 Ft. from S. Line

\_\_\_\_\_ Ft. from E. Line

330 Ft. from W. Line

Elev. 1785

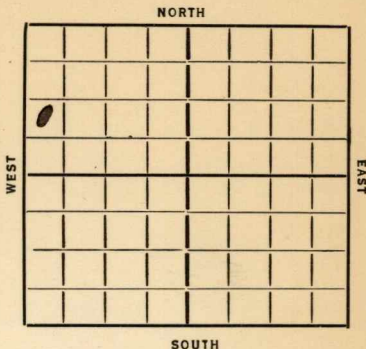

REPORT

| Date   | Description               | Depth / Notes |
|--------|---------------------------|---------------|
| 12/3   | Cellar & Material         |               |
| 12/13  | Mog.                      |               |
| 12/19  | hnd                       |               |
| 12/26  |                           |               |
| 1/6/36 | Spud                      | 20" 245       |
| 1/19   | dy 690                    | 15" 469       |
| 1/17   | " 1650                    | 12" 968       |
| 1/24   | " 1925                    |               |
| 1/31   | " 2370                    | 10" 1750      |
| 2/7    | " 2740                    |               |
| 2/14   | " 2840                    | 8" 2827       |
| 2/21   | 8" 2941 TD 2945 WOC       |               |
| 2/28   | T Sil 3238 6" 3238 WOC    |               |
| 3/6    | P.B.P. 3246               |               |
| 3/12   | Top Siliceous 3246 (Cow)  |               |
|        | TD 3271                   |               |
|        | pumped 746 Pbls Nat (Gel) |               |
| 3/18   | Sil 3246                  |               |
|        | TD 3271                   |               |
|        | 746 Pbls Nat              |               |

COMPLETED

Map No. 55 Sec. 4 Twp. 18 R. 10W

Well No. 2-Moran

Slick pyro + Lockhart et al  
Company

Contractor

FIRST REPORTS

SECTION PLAT

..... Ft. from N. Line

990 Ft. from S. Line

..... Ft. from E. Line

330 Ft. from W. Line

|   |  |  |  |
|---|--|--|--|
|   |  |  |  |
| 0 |  |  |  |
|   |  |  |  |
|   |  |  |  |
|   |  |  |  |

Location.....

Rig up.....

Drilling and Remarks:

cellar + material

RECORD

Cased..... in., ..... ft.

Sand.....

Gas.....

Oil.....

Total Depth.....

PRODUCTION

1st 24 hrs. Nat.....

1st 24 hrs. after shot.....

Gas..... Cu. Ft.

Dry Hole.....

Abandoned.....

Date

12-4-35 192.....

ORVAL MANNSCHRECK

Scout

Map No. 35 Sec. 4 Twp. 18 R. 10W

Well No. 2 Moran

Slick Pryor Lockhart et al Company

Contractor

COMPLETED

SECTION PLAT

Ft. from N. Line  
990 Ft. from S. Line  
Ft. from E. Line  
330 Ft. from W. Line

|   |  |  |  |
|---|--|--|--|
|   |  |  |  |
| 0 |  |  |  |
|   |  |  |  |
|   |  |  |  |

Location  
Rig up  
Drilling and Remarks:

RECORD

Cased \_\_\_\_\_ in., \_\_\_\_\_ ft.  
Sand Sil 3246  
Gas \_\_\_\_\_  
Oil \_\_\_\_\_  
Total Depth 3271

746 hbls natural

PRODUCTION

1st 24 hrs. Nat. \_\_\_\_\_  
1st 24 hrs. after shot. \_\_\_\_\_  
Gas \_\_\_\_\_ Cu. Ft.  
Dry Hole \_\_\_\_\_  
Abandoned \_\_\_\_\_

Date

MAR 18 1936 192

ORVAL MANNSCHRECK  
Scout