

Section 4 Township 18 Range 10W

Well No. 1 Zink

Company El Dorado Ref.

Bloomer

NORTH

WEST

EAST

SOUTH

Rice

KANSAS

✓ 10W

Sec. 4 Twp. 18 R. 10W

Well No. #1 Zink Farm

El Dorado Ref.

Company

Bloomer Pool (Lewis, Cont.)

NORTH

Ft. from N. Line

990'


Ft. from S. Line

Ft. from E. Line

330'

Ft. from W. Line

NW SW SE

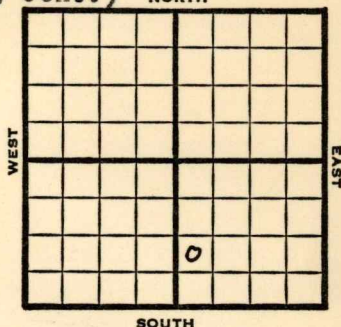

1949

Elev 1787'

REPORT

7/20

Location

7/27

8" @ 250'

Drlg 2700'

8/3

Lansing 2942'

Arb. 3262'

TD 3280'

5" @ 3263'

"

8/10

8/17

TD 3280'

Arb. 3262'

5" @ 3263'

band

ABANDONED

Kansas

Bloomer Pool

Map No. _____ Sec. 4 Twp. 18 R. 10WWell No. 1 Zink

El Dorado Ref. _____ Company _____

Lewis _____ Contractor _____

NW SW SE

FIRST REPORT
SECTION PLAT

_____ Ft. from N. Line

990 _____ Ft. from S. Line

_____ Ft. from E. Line

330 _____ Ft. from W. Line

Rice County

Location ✓

Rig up _____

Drilling and Remarks:

RECORD

Cased _____ in., _____ ft.

Sand _____

Gas _____

Oil _____

Total Depth _____

PRODUCTION

1st 24 hrs. Nat. _____

1st 24 hrs. after shot _____

Gas _____ Cu. Ft.

Dry Hole _____

Abandoned _____

Date

JUL 20 1949

19

S. J. LEWIS Scout

Kansas

Map No. 155 Sec. 4 Twp. 18 R. 10WWell No. 1 Zink

Eldorado Ref.

Company

ABANDONED

Contractor

NW SW SE

E 11282
SECTION PLAT

Ft. from N. Line

990

Ft. from S. Line

Ft. from E. Line

330

Ft. from W. Line

		0	

Rice County

Location

Rig up

Drilling and Remarks:

*Ar 43262.**5" 03263***RECORD**

Cased _____ in., _____ ft.

Sand _____

Gas _____

Oil _____

Total Depth *3280***PRODUCTION**

1st 24 hrs. Nat. _____

1st 24 hrs. after shot _____

Gas _____ Cu. Ft.

Dry Hole _____

Abandoned _____

Date

AUG 17 1949 19S. J. LEWIS Scout