


Section 26 Township 20 Range 11-W

Well No. 3 - Schrepel "A"

Company I.T.I.O.

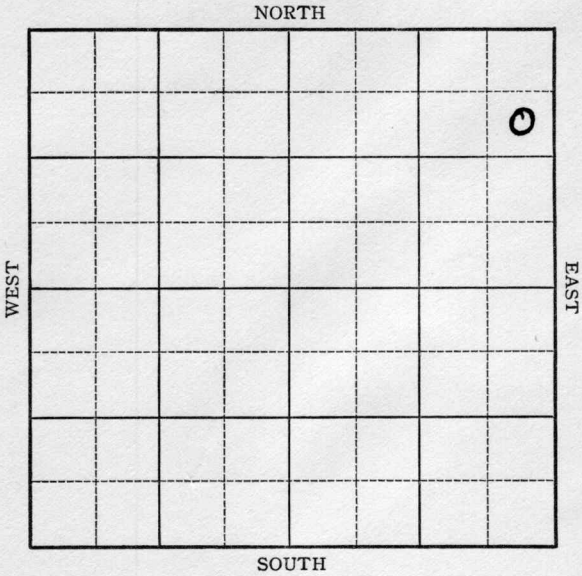

Sec. 26 Twp. 20 R. 11-W

Well No. #3 Schrepel "A" Farm


I. T. I. O. Company

990 Ft. from N. Line

         Ft. from S. Line

330 Ft. from E. Line

         Ft. from W. Line

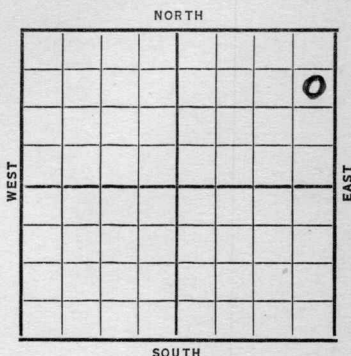

| Date            | REPORT                                  |
|-----------------|-----------------------------------------|
| 1937            |                                         |
| 8/18            | Location                                |
| 8/28            | Mat.                                    |
| 9/3             | Drlg. 1795'.                            |
| 9/10            | Sil. & 7" @ 3260'.                      |
|                 | T.D. 3262'. No shows Rep.               |
| 9/17            | " " " " "                               |
| <del>9/24</del> | " " " " "                               |
| 9/24            | T.D. 3290'. Swab 289 bbls. 6 hours.     |
|                 |                                         |
|                 |                                         |
| 9/29            | 7" @ 3260'.                             |
|                 | Sil. 3260'.                             |
|                 | T.D. 3290'.                             |
|                 | 2000 acid.                              |
|                 | Pump 360 bbls. 4 hrs & 350 bbls. 4 hrs. |
|                 | Pot. 2101 bbls.                         |
|                 |                                         |
|                 | COMPLETED                               |

*Barton* **KANSAS**Map No. \_\_\_\_\_ Sec. *26* Twp. *20* R. *11* <sup>W</sup>Well No. *3-Schrepel "A"**J. T. J. O.* Company

Contractor \_\_\_\_\_

## FIRST REPORT

## SECTION PLAT

|  |  |  |   |
|--|--|--|---|
|  |  |  |   |
|  |  |  | 0 |
|  |  |  |   |
|  |  |  |   |

*990* Ft. from N. Line

\_\_\_\_\_ Ft. from S. Line

*330* Ft. from E. Line

\_\_\_\_\_ Ft. from W. Line

Location \_\_\_\_\_

Rig up \_\_\_\_\_

Drilling and Remarks:

## RECORD

Cased \_\_\_\_\_ in., \_\_\_\_\_ ft.

Sand \_\_\_\_\_

Gas \_\_\_\_\_

Oil \_\_\_\_\_

Total Depth \_\_\_\_\_

## PRODUCTION

1st 24 hrs. Nat. \_\_\_\_\_

1st 24 hrs. after shot \_\_\_\_\_

Gas \_\_\_\_\_ Cu. Ft.

Dry Hole \_\_\_\_\_

Abandoned \_\_\_\_\_

Date

*AUG 18 1937**H. D. Hatfield* Scout

Barton KANSAS.

Map No. \_\_\_\_\_ Sec. 26 Twp. 20 R. 11WWell No. 3-Schrepel "A"

ITIO

Company \_\_\_\_\_

Contractor \_\_\_\_\_

COMPLETED

SE NE NE

990 Ft. from N. Line

\_\_\_\_\_ Ft. from S. Line

330 Ft. from E. Line

\_\_\_\_\_ Ft. from W. Line

## SECTION PLAT

|  |  |  |   |
|--|--|--|---|
|  |  |  |   |
|  |  |  | 0 |
|  |  |  |   |
|  |  |  |   |
|  |  |  |   |

Location \_\_\_\_\_

Rig up \_\_\_\_\_

Drilling and Remarks:

*2000 acid**P. - 360/4 + 350/4**Pot. - 2101*

## RECORD

Cased 7 in. 3260 ft.Sand 511 3260

Gas \_\_\_\_\_

Oil \_\_\_\_\_

Total Depth 3290

## PRODUCTION

1st 24 hrs. Nat. \_\_\_\_\_

1st 24 hrs. after shot \_\_\_\_\_

Gas \_\_\_\_\_ Cu. Ft.

Dry Hole \_\_\_\_\_

Abandoned \_\_\_\_\_

Date

SEP 29 1937

19

H. D. Hatfield

Scout