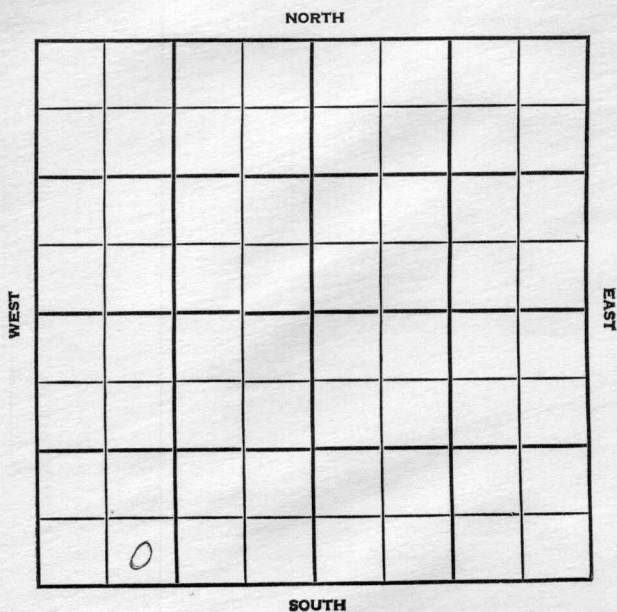


Section 27 Township 20 Range 11WWell No. #1 Hagen "B"Company Alpine O&R

WILDCAT

FORM 513 SUNRAY

County Barton Elev. _____
 Sec. 27 Twp. 20 Rge. 11W
 Company Alpine O. & R.
 Farm Name Hagen "B" No. 1

TOPS	DEPTH	LOG	DATUM	Loc. in Sec.
Anh.				SE SW SW
Tp.				
H.				
Tr.				
Dg.				
B.L.				
L.				
K.C.				Geol. _____
B.K.C.				Contr. _____
Ce.				Quaker Tools
C.				
M.				Pool
M.				Wildcat
K.				
Mz.				
Me.				
V.				
S.				
S.				
A.				
R.				
Pe.				
G.				
T.D.				

FIRST REPORT	
OCT 31	1956

Date Comm. spd. 10-29-56
8" @ 205 w/225, WOC

NOV 5 1956

R.O.

15

County Barton Elev. 1783
 Sec. 27 Twp. 20 Rgs. 11W
 Company Alpine O. & R.
 Farm Name Hagen "B" No. 1

TOPS	DEPTH	LOG	DATUM	Loc. in Sec.
Anh.				SE SW SW
TP.				
H.	2952			
Tr.				
Dg.				
Bl.	3075			
L.	3095			Geol.
K.C.				Contr.
B.K.C.	3326			Quaker Tools
Ce.				Pool
C.				Wildcat
M.				
M.				
K.				
Mz.				
Mq.				
V.				
S.				
S.				
A.	3343			
R.				
Pe.				
G.				
TD.	3352			

ABANDONED

NOV 15 '56

Date Comm. spd. 10-29-56

8" @ 205 w/225, WOC NOV 7 '56 3000 NOV 13 '56

DST 3345-52 1hr 75' Md BHP
25/20"

D&A