
DX 78-1 Barton **KANSAS**

Section 29 Township 20S Range 11W

Well No. #5 Hagen

Company L. K. Parrish

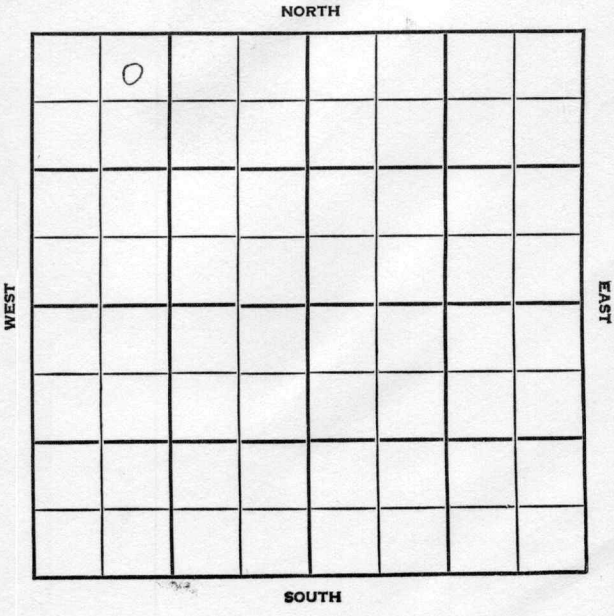

Barton KANSAS

SEC.	TWP.	R.
29	20S	11W

WELL NO. #5 Hagen FARM

COMPANY L.K. Parrish

CONTRACTOR Quaker

Kowalsky


_____ FT. FROM N. LINE

_____ FT. FROM S. LINE

_____ FT. FROM E. LINE

_____ FT. FROM W. LINE

NE NW NW

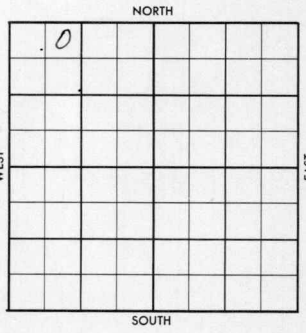

1956 ELEVATION 1809 KB REPORT

7-25 Comm. 7-19-56
8" @ 225 w/225
Drlg. 2506'

8-15 5½" @ 3331 w/100
CO 3334
DD 3336, 55 gal. acid; no inc.
DD 3348; FU 1350' oil, 8 hrs.
S/ 33 BO no/wtr.,
S/ 2 boph, no/wtr., 3 hrs.
DD 3349
FU 2000' oil
P/ 75 bopd, no/wtr.
Anh. 555'; H. 2948'; BL. 3078';
L. 3094'; A. 3328';
TD 3349

COMPLETED

FORM 504-5 SUNRAY

FORM 513 SUNRAY

County Barton Elev.

Sec. 29 Twp. 20S Rge. 11W

Company L. K. Parrish

Farm Name Hagen No. 5

TOPS	DEPTH	LOG	DATUM
Anh.			
T.P.			
H.			
Tr.			
Dg.			
B.L.			
L.			
K.C.			
B.K.C.			
Ce.			
C.			
M.			
M.			
K.			
Mz.			
Mo.			
V.			
S.			
S.			
A			
R.			
P€.			
G.			
T.D.			

Loc. in Sec. NE NW NW

Geol.

Contr. Quaker

Pool Kowalsky

JUL 25 1956

FIRST REPORT

Date Comm. 7/19/56

8" 225 w/225 D 2506

Co. Lse. No. Sec. T. R.

FORM 513 SUNRAY

County Barton Elev. 1809 KB

Sec. 29 Twp. 20S Rge. 11W

Company L. K. Parrish

Farm Name Hagen No. 5

TOPS	DEPTH	LOG	DATUM
Anh.	555		
Tp.			
H.	1948		
Tr.			
Dg.			
B.L.	3073		
L.	3094		
K.C.			
B.K.C.			
Ce.			
C.			
M.			
M.			
K.			
Mz.			
Me.			
V.			
S.			
S.			
A	3333		
R.			
P&.			
G.			
T.D.	3334		

Loc. in Sec. NE NW NW

Geol.

Contr. Quaker

Pool Kowalsky



AUG 15 '56

Date Comm. 7/19/56

8" 225 w/225 D 2506 AUG 1 56

5" 1/3331/100 AUG 8 '56 AUG 15 '56

CO 3334 OD 3336 55 gal acid no inc OD 3348 FO 1350' oil & hrs & 33 Bo no/w & 2 Boph no/w 3 hrs OD 3349 TD FO 2000' oil Pot. P. 75 Bopd no/wtr.

Co. Lse. No. Sec. T. R.