


Section 28 Township 20 Range 11W

Well No. 1 Hagen "B"

Company W.L. Hartmen

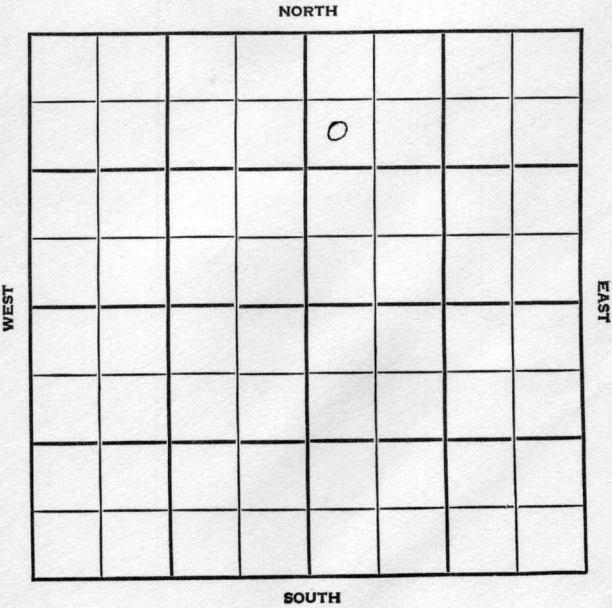

Barton

KANSAS

SEC.	TWP.	R.
28	20	11W

WELL NO.

1 Hagen "B"

FARM

COMPANY

W. L. Hartman

CONTRACTOR

Co. Tools

Semi Wildcat


_____ Ft. from N. Line

_____ Ft. from S. Line

_____ Ft. from E. Line

_____ Ft. from W. Line

SW NW NE

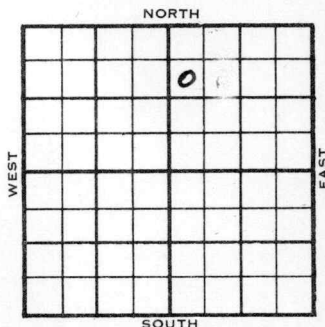

ELEVATION

REPORT

1955

1780'

5/26

Comm 5-3-55

10" @ 206

Topeka 2665'; Heebner Sh 2935';

Brown Lime 3063'; Lansing 3084'

Drlg 3270

5/26

Spud 5-3-55 10" @ 206

D & A TD 3430'

Tops: Topeka 2665', Heebner Sh 2935'

Brown lime 3063', Lansing 3084',

Simpson 3334', Arbuckle 3380'

TD 3430' D & A

ABANDONED

Twp..... Pool.....

Co..... Facet.....

FORM 513 REV. SUNRAY


FIRST REPORT

County Barton Elev. 1780
 Sec. 28 Twp. (20) Rge. 11W
 Company W. L. Hartman
 Farm Name Hagen "B" No. 1

TOPS	DEPTH	DATUM
Cim. Anhydrite		
Ft. Riley		
Howard		
Topeka	2665	
Heebner Sh.	2935	
Toronto Ls.		
Brown Lime	3063	
Lansing	3084	
Kans. City		
B. K. C.		
Congl.		
Miss.		
Kinderhook		
Misener		
Hunton		
Sylv. Maquo		
Viola		
Simpson		
Smp.		
Gorham		
Arbuckle		
Basal Sand		
Pre. Cam.		
T. D.		

Loc. in Section

SW NW NE

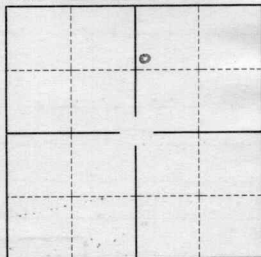Drlg. Contr. Co. toolsPool Semi WildcatDate Comm. 5-3-55

Date Comp.

10" @ 206 drlg. 3270

FIRST REPORT

ABANDONED

FORM 513 REV. SUNRAY


County Barton Elev. 1780
 Sec. 28 Twp. 20 Rge. 11W
 Company W. L. Hartman
 Farm Name Hagen "B" No. 1

TOPS	DEPTH	DATUM
Cim. Anhydrite		
Ft. Riley		
Howard		
Topeka	2665	885
Heebner Sh.	2935	1155
Toronto Ls.		
Brown Lime	3063	1283
Lansing	3084	1304
Kans. City		
B. K. C.		
Congl.		
Miss.		
Kinderhook		
Misener		
Hunton		
Sylv. Maquo		
Viola		
Simpson	3334	1554
Smp.		
Gorham		
Arbuckle	3380	1600
Basal Sand		
Pre. Cam.		
T. D.	3430	

Loc. in Section
SW NW NE

Drlg. Contr.

Pool

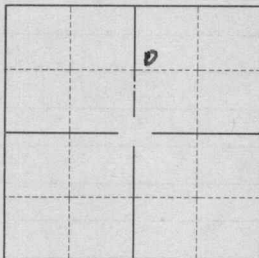

Date Comm.

Date Comp.

MAY 25 '55

Spud 5-3-55 10" @ 206

D & A

Co.

Lse.

No.

S.

T.

R.