
FORM 51 25M 8-50 WESTERN

Barton KANSAS

Section 28 Township 20 Range 11W

Well No. #1 Haggen

Company Murfin Drlg.

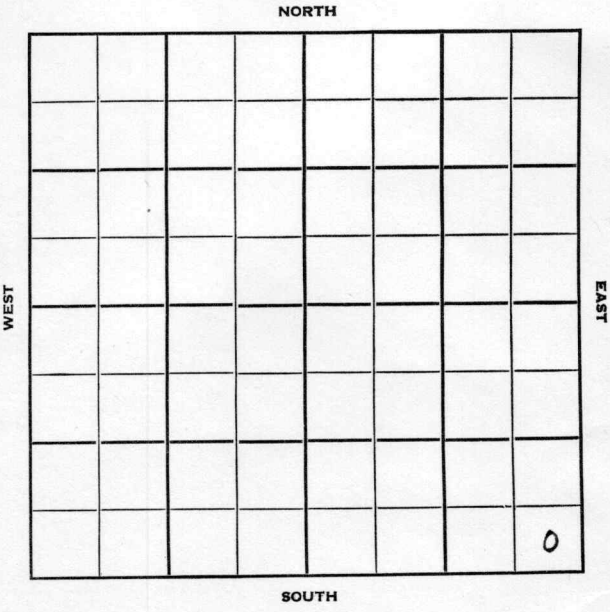

FORM 252-B

Barton KANSAS

Sec. 28 Twp. 20 R. 11W

Well No. #1 Haggen Farm

Murfin Drlg. Company

Contractor


Ft. from N. Line

330 Ft. from S. Line

330 Ft. from E. Line

Ft. from W. Line

SE SE SE
CSO-acreage

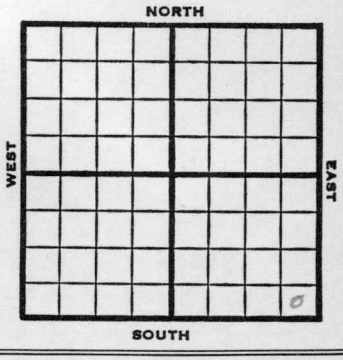

1953	Elev. 1786' REPORT
6/3	Spud 5-25-53 8" @ 175' Anhy 525' Drlg 2948'
6/10	Spud 5-25-53 D & A TD 3393 8" @ 175 Anhy 525 Heeb 2959 Tor 2975 Br lime 3081 Lans 3100 DST 3187-96 open 40 min rec 360' SW Arb. 3359 DST 3359-64 open ½ hr rec 23' mud DST 3363-93 open ½ hr rec 426' SW 630# TD 3393 D & A ABANDONED

FORM 275 FOR SALE BY KANSAS BLUE PRINT CO.


County Barton State Kansas

Sec. 28 (Blk. Twp.) 20 (Sur. Rge.) 11W Map No.

Operator Murfin Drlg.

Well No. 1 Farm Haggen

Elev. Location SE SE SE

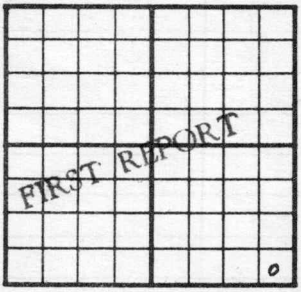

330 Ft. From S Line SE

330 Ft. From E Line Quarter

1st. Report JUN 3 1953

Completion

Remarks CSO-acreage

Spudding Date 5-25-53

Drlg. Data

8" @ 175 Anhy 525 drlg. 2948

J. G. McGEHEE

FORM 275 FOR SALE BY KANSAS BLUE PRINT CO.

County Barton State Kansas

Sec. 28 (Blk. Twp.) 20 (Sur. Rge.) 11W Map No.

Operator Murfin Drlg.

Well No. 1 Farm Haggen

Elev. 1786 Location SE SE SE



330 Ft. From S Line SE

330 Ft. From E Line Quarter

1st. Report

Completion JUN 1 0 1953

Remarks

Spudding Date 5-25-53

Drlg. Data D & A TD 3393

8" @ 175 Anhy 525 Heeb. 2959

Tor. 2975 Br. lime 3081 Lans. 3100

DST 3187-96 open 40 min. Rec. 360' sw

Arb. 3359 DST 3359-64 open ½ hr.

Rec. 23' mud DST 3363-93 open ½ hr.

Rec. 426' sw 630# TD 3393

D & A

J. G. McGEHEE