

KANSAS


Form 51—5M—11-38—Palace

Barton

Section 29 Township 20 Range 11-W

Well No. #2 Hagen

Company Kaiser & Branine et al

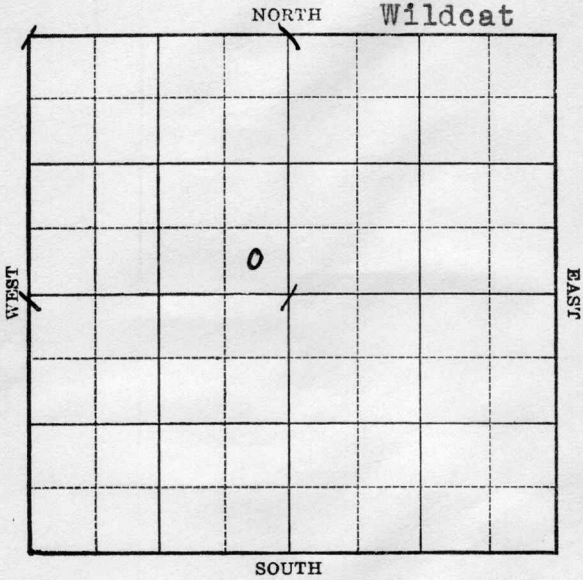

Barton

KANSAS

Map No. 40 Sec. 29 Twp. 20 R. 11WWell No. 2 HagenKaiser & Branine etal Company

Contractor

FIRST REPORT


SE NW

_____ Ft. from N. Line

330 Ft. from S. Line330 Ft. from E. Line

_____ Ft. from W. Line

SECTION PLAT

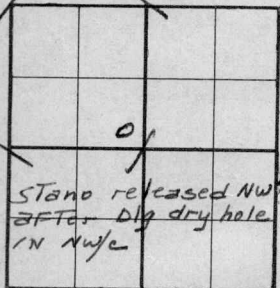

WILDCAT

Location _____

Rig up _____

Drilling and Remarks:

SH

RECORD

Cased _____ in., _____ ft.

Sand _____

Gas _____

Oil _____

Total Depth _____

PRODUCTION

1st 24 hrs. Nat. _____

1st 24 hrs. after shot _____

Gas _____ Cu. Ft.

Dry Hole _____

Abandoned _____

Date

JAN 25 1939

19

H. D. Hatfield Scout

Map No. _____ Sec. 29 Twp. 20 R. 11WWell No. 2 HagenKaiser & Branine etal Company

Contractor

ABANDONED

SE NW

_____ Ft. from N. Line

330 Ft. from S. Line330 Ft. from E. Line

_____ Ft. from W. Line

WILDCAT

SECTION PLAT

Location _____

Rig up _____

Drilling and Remarks:

LANS 3110
 Cherty Cong 3383
 Arb 3550
 T.D. 3552

DYA

RECORD

Cased _____ in., _____ ft.

Sand ~~Arb~~ _____

Gas _____

Oil _____

Total Depth _____

PRODUCTION

1st 24 hrs. Nat. _____

1st 24 hrs. after shot _____

Gas _____ Cu. Ft.

Dry Hole _____

Abandoned _____

Date
FEB 8 1939

19

H.D.H.

Scout

By Paul