
FORM 51

Barton KANSAS

Section 29 Township 20 Range 11 W

Well No. # 2 Hagan

Company L. K. Parrish

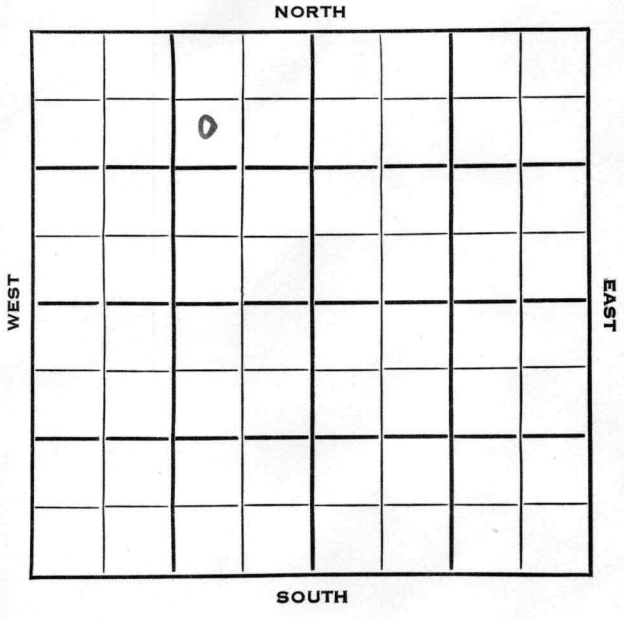

Barton KANSAS

SEC.	TWP.	R.
29	20	11 W

WELL NO.

2 Hagan FARM
COMPANY

L. K, Parrish
CONTRACTOR

Quaker Drlg.


820 Ft. from N. Line

Ft. from S. Line

990 Ft. from E. Line

Ft. from W. Line

SW NE NW

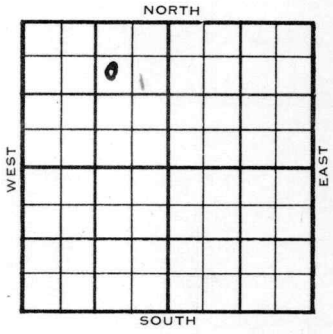

1953	ELEVATION 1800'	REPORT
10/14	Spud 10-1-53 Anhy 540' Heeb 2947' Br lime 3077' KC 3093' Arb. 3323' TD 3326' 5" @ 3325	
10/28	Spud 10-1-53 Oil well TD 3329 Anhy 540' Heeb 2947' Br. lime 3077' KC 3093 Arb. 3323' TD 3326 5" @ 3325 DD 3329 4 BO 6 hr. 500 A 15½ BO 12 hr. Comp/ 25 BOPD	

COMPLETED

DX-78

FORM 275 FOR SALE BY KANSAS BLUE PRINT CO.

County Barton State Kansas

Sec. 29 (Blk. Twp.) 20 (Sur. Rge.) 11W Map No.

Operator L. K. Parrish

Well No. 2 Farm Hagan

Elev. 1800 Location SW NE NW



820 Ft. From N Line NW

990 Ft. From E Line Quarter

1st. Report OCT 14 1953

Completion

Remarks Quaker Drlg. - Contr.

Spudding Date 10-1-53

Drlg. Data

Anhy 540 Heeb. 2947 Br. lime 3077

KC 3093 Arb. 3323 TD 3326 5" @3325

J. G. McGEHEE

FORM 275 FOR SALE BY KANSAS BLUE PRINT CO.


County Barton State Kansas

Sec. 29 (Blk. Twp.) 20 (Sur. Rge.) 11W Map No.

Operator L. K. Parrish

Well No. 2 Farm Hagan

Elev. 1800 Location SW NE NW

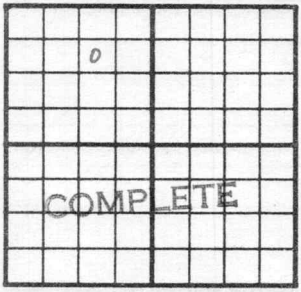

820 Ft. From N Line NW

990 Ft. From E Line Quarter

1st. Report

Completion OCT 28 1953

Remarks

Quaker Drlg. - Contr.

Spudding Date 10-1-53

Drlg. Data Oil well TD 3329

Anhy 540 Heeb. 2947 Br. lime 3077

KC 3093 Arb. 3323 TD 3326 5" @ 3325

DD 3329 4 bo 6 hr. 500 A 15½ bo

12 hr. Comp. 25 bopd

J. G. McGEHEE