DX 78-1


Barton

KANSAS

Section 29 Township 20 Range 11W

Well No. #4 Hagen

Company L.K. Parrish

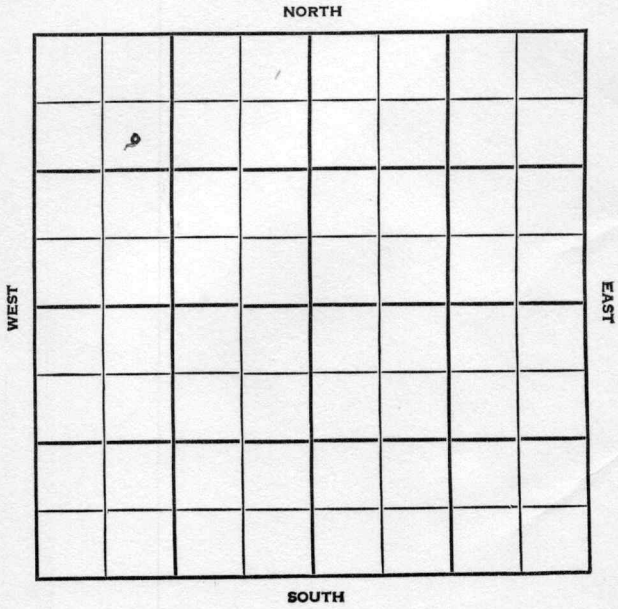

Barton KANSAS

SEC.	TWP.	R.
29	20	11W

WELL NO.

4 Hagen FARM

COMPANY

L. K. Parrish

CONTRACTOR

Quaker Drlg.

Kowalsky Pool


990 Ft. from N. Line

Ft. from S. Line

Ft. from E. Line

990 Ft. from W. Line

SE NW NW

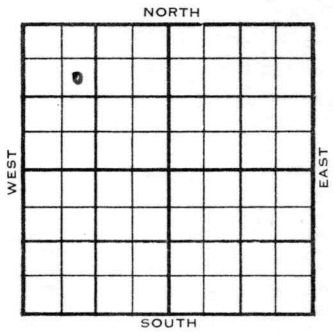

1954 ELEVATION 1803' REPORT

10/6 Spud 10-4-54
8" @ 215', WOC

1955
1/5 Spud 10-4-54 - Oil Well
TD 3341'
8" @ 215'
Heeb. 2941', Br lime 3071', Lans. 3086', Arb. 3318'
TD 3324'
5" @ 3321'
DD 3341' 500A
1250A
S/4 boph
P/3½ boph
Comp. 25 bopd

COMPLETED

DX-78

FORM 275 FOR SALE BY KANSAS BLUE PRINT CO.

County Barton State Kansas

Sec. 29 (Blk. Twp.) 20 (Sur. Rge.) 11W Map No.

Operator L. K. Parrish

Well No. 4 Farm Hagen

Elev. Location SE NW NW



990 Ft. From N Line NW

990 Ft. From W Line Quarter

1st. Report OCT 6 1954

Completion

Remarks Quaker Drlg. - Contr.

Spudding Date 10-4-54

Drlg. Data Kowalsky Pool

8" @ 215 WOC

FABEN GILSTRAP

FORM 275 FOR SALE BY KANSAS BLUE PRINT CO.


County Barton State Kansas

Sec. 29 (Blk. Twp.) 20 (Sur. Rge.) 11W Map No.

Operator L. K. Parrish

Well No. 4 Farm Hagen

Elev. 1803 Location SE NW NW

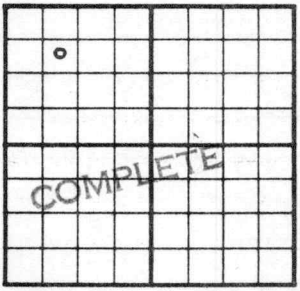

990 Ft. From N Line NW

990 Ft. From W Line Quarter

1st. Report

Completion JAN 5 1955

Remarks Kowalsky Pool

Quaker Drlg. - Contr.

Spudding Date 10-4-54

Drlg. Data Oil well TD 3341

8" @ 215 Heeb. 2941 Br. lime 3071

Lans. 3086 Arb. 3318 TD 3324

5" @ 3321 DD 3341 500 A 1250A

S/ 4 boph P/ 3½ boph Comp. 25 bopd

FABEN GILSTRAP