
FORM 51

Barton KANSAS

Section 29 Township 20 Range 11W

Well No. 3 Hager

Company L. K. Parrish

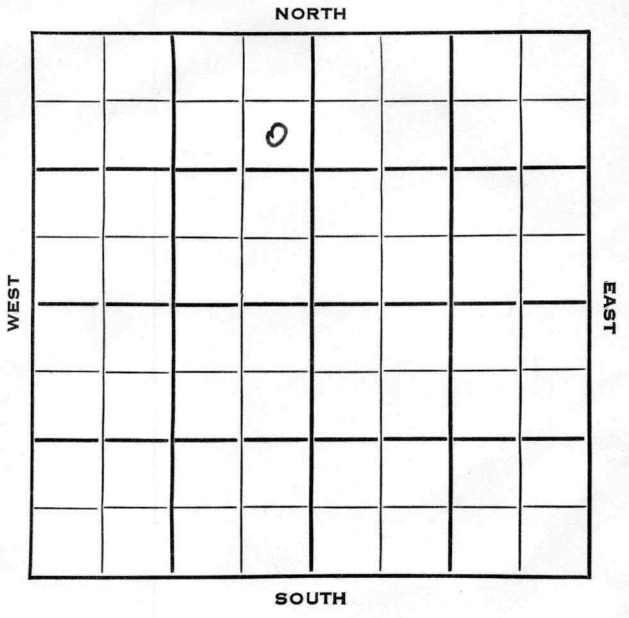

Barton KANSAS

SEC.	TWP.	R.
29	20	11W

WELL NO.

3 Hager FARM

COMPANY

L. K. Parrish

CONTRACTOR

Garvey

Hagan Pool


990 Ft. from N. Line

Ft. from S. Line

330 Ft. from E. Line

Ft. from W. Line

SE NE NW

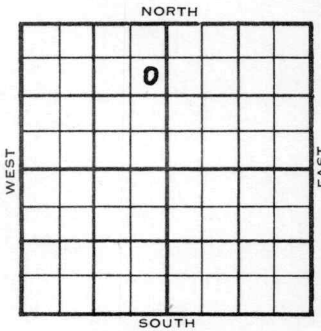

1954	ELEVATION 1800'	REPORT
2/3		Spud 1-23-54 8" @ 232' Anhy 542' Drlg. 2000'
2/10		NR
2/17		NR
2/24		"
3/3		"
3/10		"
3/17		"
3/24		Spud 1-23-54 Oil well TD 3335' 8" @ 232 Anhy 542 Heeb 2955 Br. lim3 3086 Lans 3101 Arb. 3331 TD 3335 5" @ 3334 CO to 3335 FU 225' oil 500 A 1500 A FU 400' oil 14 hr. DD 3338 S/1-3/4 BOPH 8 hr. Comp. 13 BOPD

COMPLETED

DX-78

FORM 275 FOR SALE BY KANSAS BLUE PRINT CO.


County Barton State Kansas

Sec. 29 (Blk. Twp.) 20 (Sur. Rge.) 11W Map No.

Operator L. K. Parrish

Well No. 3 Farm Hager

Elev. Location SE NE NW

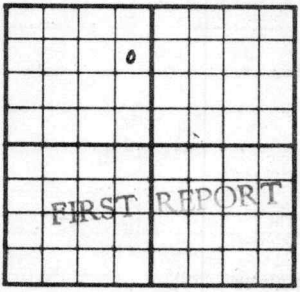

990 Ft. From N Line NW

330 Ft. From E Line Quarter

1st. Report FEB 3 1954

Completion

Remarks

Garvey - Contr.

Spudding Date 1-23-54

Drlg. Data Hagan Pool

8" @ 232 Anhy 542 drlg. 2000

J. G. McGEHEE

FORM 275 FOR SALE BY KANSAS BLUE PRINT CO.


County Barton State Kansas

Sec. 29 (Blk. Twp.) 20 (Sur. Rge.) 11W Map No.

Operator L. K. Parrish

Well No. 3 Farm Hager

Elev. 1800 Location SE NE NW

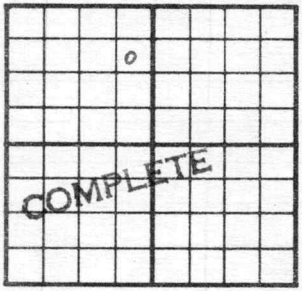

990 Ft. From N Line NW

330 Ft. From E Line Quarter

1st. Report

Completion MAR 24 1954

Remarks Hagan Pool
Garvey - Contr.

Spudding Date 1-23-54

Drlg. Data Oil well TD 3335

8" @ 232 Anhy 542 Heeb. 2955

Br. lime 3086 Lans. 3101 Arb. 3331

TD 3335 5" @ 3334 CO to 3335

FU 225' oil 500 A 1500 A FU 400' oil

14 hr. DD 3338 S/ 1 3/4 boph 8 hr.

Comp. 13 bopd

J. G. McGEHEE