


Section 29 Township 20 Range 11 W

Well No. # 1 Sessler

Company K & E Drlg. & Geo. Nye

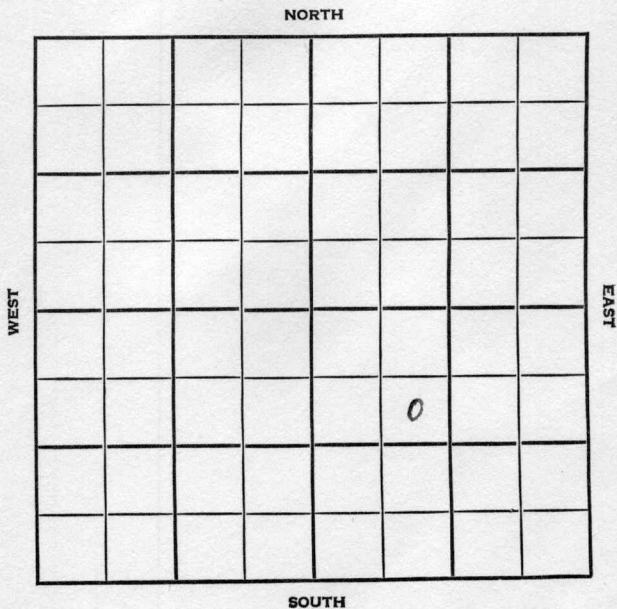

Barton

KANSAS

SEC.	TWP.	R.
29	20	11 W

WELL NO. # 1 Sessler FARM
 COMPANY

CONTRACTOR K & E Drlg. & Geo. Nye


Co. tools
 Kowalsky

_____ Ft. from N. Line

_____ Ft. from S. Line

_____ Ft. from E. Line

_____ Ft. from W. Line

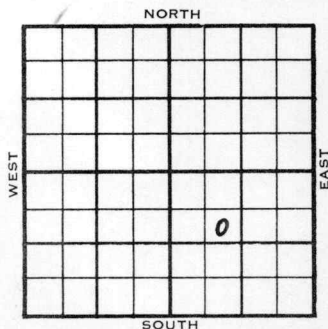

SE NW SE

ELEVATION

REPORT

1955

1797'

6/8

Comm. 6-1-55
 8" @ 275 w/180
 Drlg. 2795'

6/15

Comm. 6-1-55
 8" @ 275/180
 DST 3348-53, open 1 hr rec 8' mud
 620#
 DST 3350-59 open 25 min, rec 360' mud
 SSO. D & A
 H. 2970', L. 3105', A. 3349',
 TD 3378' D & A

ABANDONED

County Barton ✓ Elev. _____
 Sec. 29 Twp. 20 Rge. 11W
 Company K & E Drlg. & Geo. Nye
 Farm Name Sessler No. 1

Co.

TOPS	DEPTH	LOG	DATUM
Anh.			
Tp.			
H.			
Tr.			
Dg.			
BL.			
L.			
K.C.			
B.K.C.			
Ce.			
C.			
M.			
M.			
K.			
Mz.			
Mq.			
V.			
S.			
S.			
A			
R.			
Pe.			
G.			
T.D.			

Loc. in Sec. SE NW SE

Geol. _____

Contr. _____

Co. tools _____

Pool _____

Kowalsky

FIRST REPORT

JUN 9 '55

Lse.

No.

Sec.

T.

R.

Date Comm. 6-1-55
8" @ 275/180 drlg. 2795

County Barton Elev. 1797
 Sec. 29 Twp. 20 Rgs. 11W
 Company K & E Drlg. & G eo. Nye
 FarmName Sessler No. 1

TOPS	DEPTH	LOG	DATUM
Anh.			
Tp.			
H.	<u>2970</u>		<u>1173</u>
Tr.			
Dg.			
Bl.			
L.	<u>3105</u>		<u>1308</u>
K.C.			
B.K.C.			
Ce.			
C.			
M.			
M.			
K.			
Mz.			
Mq.			
V.			
S.			
S.			
A	<u>3349</u>		<u>1552</u>
R.			
Pe.			
G.			
T.D.	<u>3378</u>		

Loc. in Sec. SE NW SE
 Geol. _____
 Contr. Co. tools
 Pool Kowalsky



Date Comm. 6-1-55 JUN 15 1955
8" @ 275/180 DST 3348-53 open 1 hr.
Rec. 8' mud 620# DST 3350-59
open 25 min. Rec. 360' mud SSO
D & A

Co.
 Lse.
 No.
 Sec.
 T.
 R.