


Section 29 Township 20 Range 11 W

Well No. # 2 Sessler

Company Anschutz Drlg.

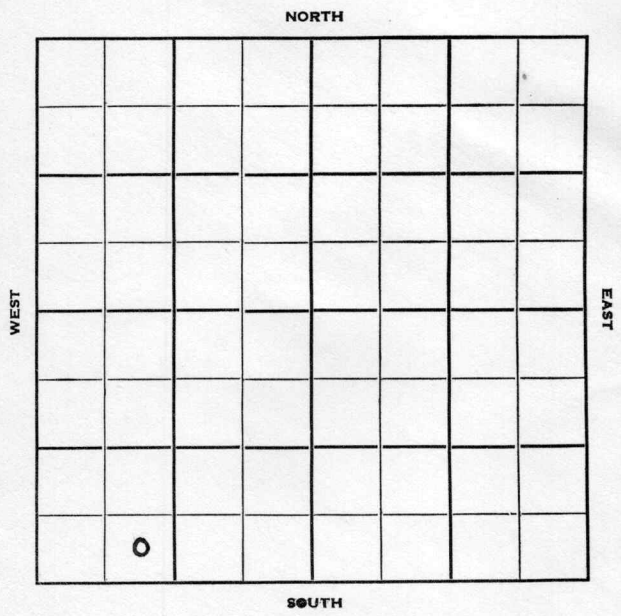



Well No. #2 Sessler Farm

Anschutz Drlg. Company

Anschutz Drlg. -Contr. Contractor

Kowalsky Pool


Ft. from N. Line

330' Ft. from S. Line

Ft. from E. Line

990' Ft. from W. Line

SE SW SW

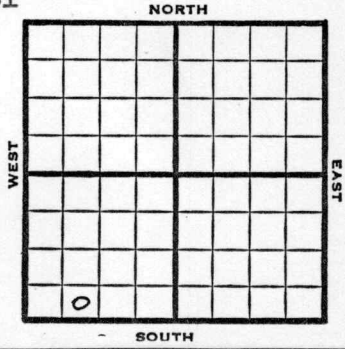

1951

Elev. 1807' REPORT

2/7

Spud 2-5-51
8" @ 320' WOC

2/21

Spud 2-5-51
D & A TD 3405
8" @ 302
Heeb. 2975 Br. lime 3106
Lans. 3122 Arb. 3367
TD 3405 D & A

ABANDONED

County Barton State Kansas

Sec. 29 (Blk.) 20 (Sur.) 11W Map No.
(Twp.) (Rge.)

Operator Anschutz Drlg.

Well No. 2 Farm Sessler

Elev. Location SE SW SW

FIRST REPORT							
<u>0</u>							

330 Ft. From S Line SW

990 Ft. From W Line Quarter

1st. Report FEB 7 1951

Completion _____

Remarks _____

Anschutz Drlg. - Contr.

Spudding Date 2-5-51

Drlg. Data Kowalsky Pool

8" @ 302 WOC

J. E. TYRA

County Barton State Kansas

Sec. 29 (Blk.) 20 (Sur.) 11W Map No.

Operator Anschutz Drlg.

Well No. 2 Farm Sessler

Elev. 1807 Location SE SW SW

ABANDONED

330 Ft. From S Line SW

990 Ft. From W Line Quarter

1st. Report _____

Completion FEB 21 1951

Remarks Kowalsky Pool

Anschutz Drlg. - Contr.

Spudding Date 2-5-51

Drlg. Data D & A TD 3405

8" @ 302 Heeb. 2975 Br. line 3106

Lans. 3122 Arb. 3367 TD 3405

D & A