


Section 30 Township 20 Range 11-W

Well No. #1 Jutting

Company Bay Pet.  
Kowalsky Pool

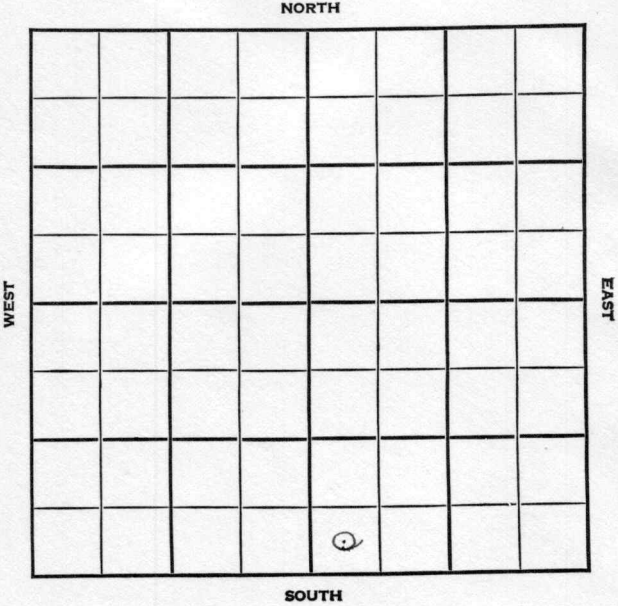



Sec. 30 Twp. 20 R. 11W

Well No. #1 Jutting Farm

Bay Pet.

Company

Kowalsky Pool


Ft. from N. Line

330' Ft. from S. Line

Ft. from E. Line

330' Ft. from W. Line

SW SE

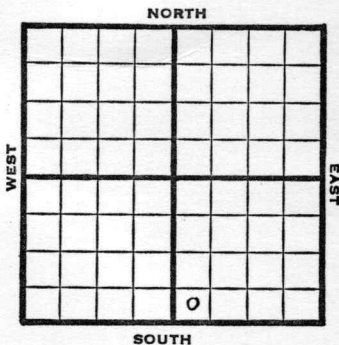

1948

Eli 1815'

REPORT

5/26

RUR

6/1

8" @ 580'  
Drlg. 2556'

6/9

Lansing 3128'  
Arbuckle 3354'  
5" @ 3354'  
TD 3355'  
RUST

6/16

Swb 20 bbls oil PH 3 hrs.

6/23

"

6/29

"

7/8

"

7/14

"

7/21

"

7/28

Pump 114 bbls oil in 8 hrs.

8/4

Arb. 3354'  
5" @ 3354'  
TD 3355'  
500 acid  
Pump 470 oil Pot  
39° Gr.

Comp

**COMPLETED**

Map No. \_\_\_\_\_ Sec. 30 Twp. 20 R. 11W

Well No. 1 Jutting

Bay Pet. \_\_\_\_\_ Company

FIRST REPORT

\_\_\_\_\_  
Contractor

SW SE

SECTION PLAT

\_\_\_\_\_ Ft. from N. Line

330 Ft. from S. Line

\_\_\_\_\_ Ft. from E. Line

330 Ft. from W. Line


Barton County

Location \_\_\_\_\_

Rig up \_\_\_\_\_

Drilling and Remarks:

R U R

RECORD

Cased \_\_\_\_\_ in., \_\_\_\_\_ ft.

Sand \_\_\_\_\_

Gas \_\_\_\_\_

Oil \_\_\_\_\_

Total Depth \_\_\_\_\_

PRODUCTION

1st 24 hrs. Nat. \_\_\_\_\_

1st 24 hrs. after shot \_\_\_\_\_

Gas \_\_\_\_\_ Cu. Ft.

Dry Hole \_\_\_\_\_

Abandoned \_\_\_\_\_

Date

MAY 26 1948

19

S. J. LEWIS

Scout

