


Section 30 Township 20 Range 11W

Well No. #4 Jutting

Company Bay Petroelum

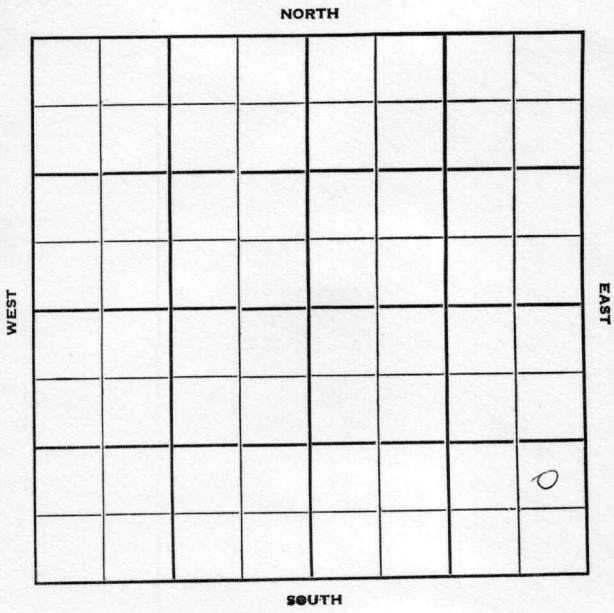

Barton

KANSAS

Sec. 30 Twp. 20 R. 11W

Well No. #4 Jutting Farm

Bay Petroleum Company

Pickrell Drlg. - Contr. Contractor

Kowalsky Pool


 Ft. from N. Line

990' Ft. from S. Line

330' Ft. from E. Line

 Ft. from W. Line

NE SE SE

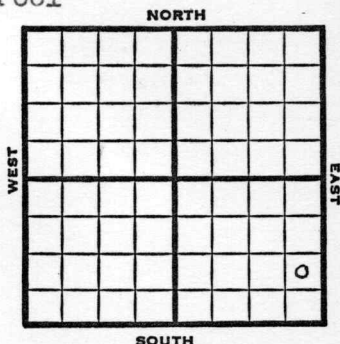

1951

Elev. 1811' REPORT

3/21

Location

6/13

Spud 3-20-51

Oil well TD 3356'

Anhy 566' 8" @ 576 Heeb 2974'

Br. lime 3108' Lans. 3121'

DST 3123-52 open 45 min. rec 15' mud

DST 3246-74 open 45 min. rec 15' mud

Arb. 3353' TD 3355' 5" @ 3354

FU 1700' oil 1 hr. DD 3356'

S/ 24 BOPH

Comp. 910 BOPD

COMPLETED

J. E. TYRA

Sec.

Operator

Well No.

Elev.

990 Ft. From

330 Ft. From

1st. Report

Completion JUN 13 1951

Remarks Kowalsky Pool

Pickrell Drlg. - Cont

Spudding Date 3-20-51

Drlg. Data

Anhv 566 8" @ 576 Heeb. 2974

Br. lime 3108 Lans. 3121 DST ~~3123~~

52 open 45 min. Rec. 15' mud

DST 3246-74. open 45 min. Rec. 15

mud Arb. 3353 TD 3355 5" @ 3354

FU 1700' oil 1 hr. DD 3356

S/ 24 boph Comp. 910 bopd

J. E. TYRA